


T.16S.R.1W.W.M.

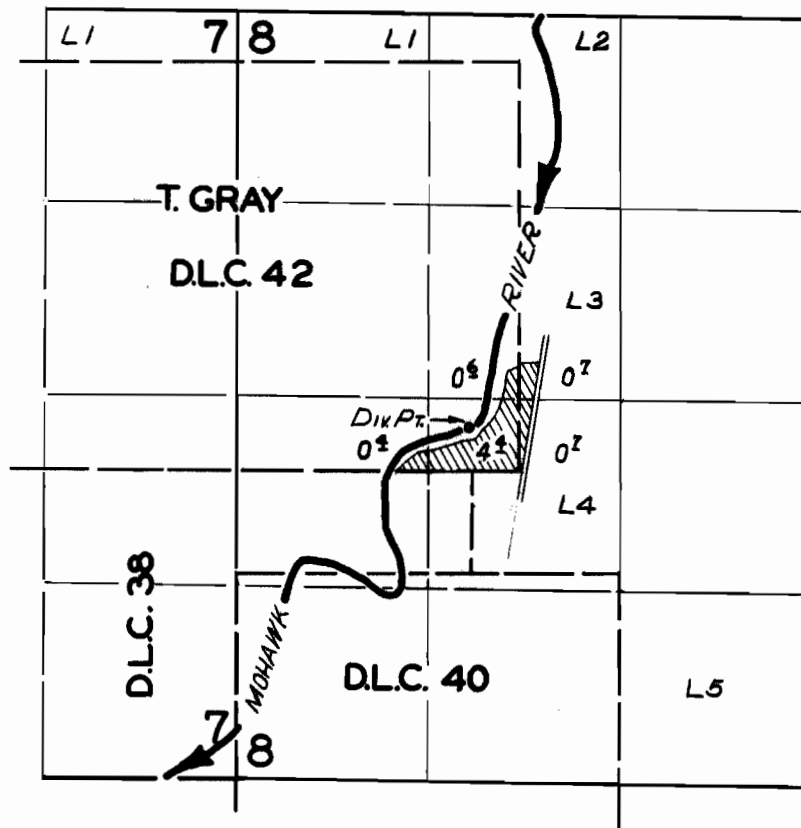

FINAL PROOF SURVEY
UNDER

Application No. 33911..... Permit No. 26717.....
IN NAME OF

.....ELMER H. BAKER.....

Surveyed May 10.... 1961.., by M.K.B. & H.....