


T.16S.R.7 W.W.M.

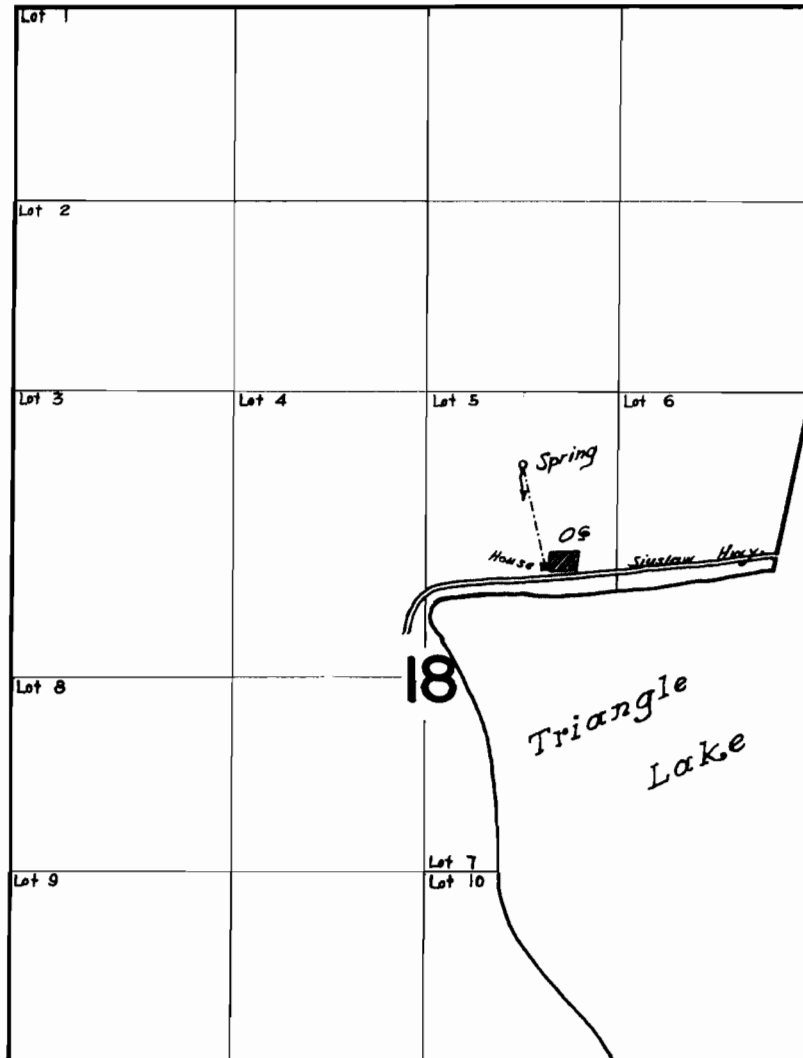

Note: Location & extent of development from Application Map.

**FINAL PROOF SURVEY
UNDER**

Application No. 34135 Permit No. 26899
IN NAME OF

RALPH SCHMITT

Surveyed May 24 1961, by R. H. Jackson