


T.17 S.R. 4 W.W.M.

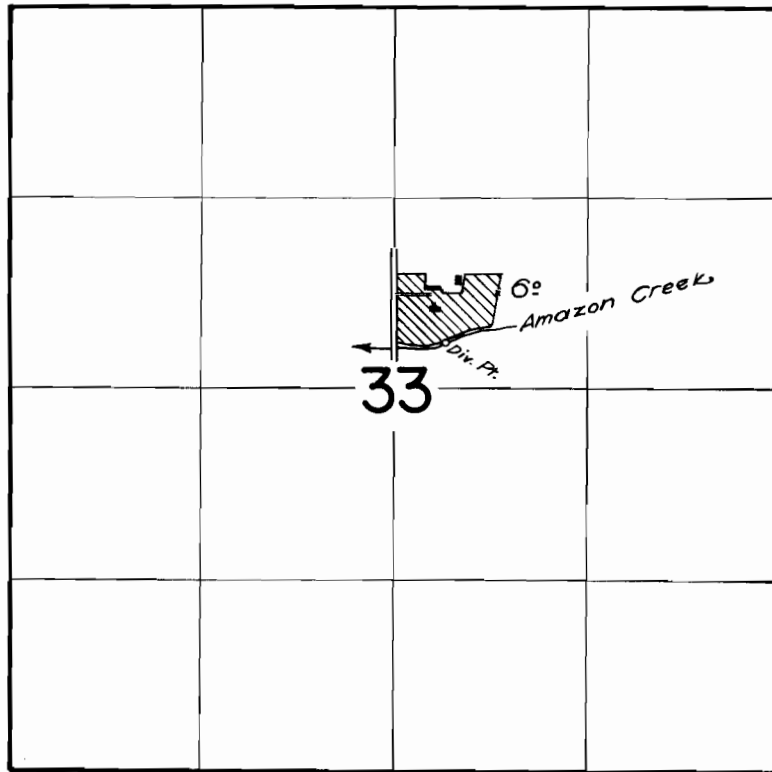

FINAL PROOF SURVEY
UNDER

Application No. 34441 Permit No. 27044
IN NAME OF

EMIL S. MATSON

Surveyed May 26 1961, by L. Jackson