


T.13S.R.2E.W.M.

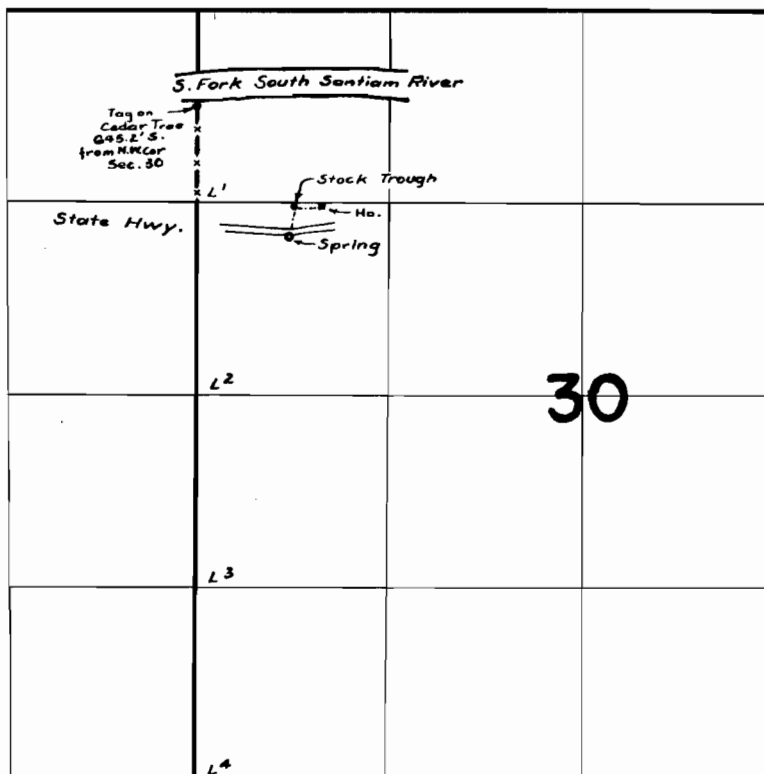

FINAL PROOF SURVEY UNDER

Application No. 32760 Permit No. 26052
IN NAME OF

GEORGE V. LUTES

Surveyed 8 JUNE 1961, by Tr. Bish