


T.19S.R.47E.W.M.

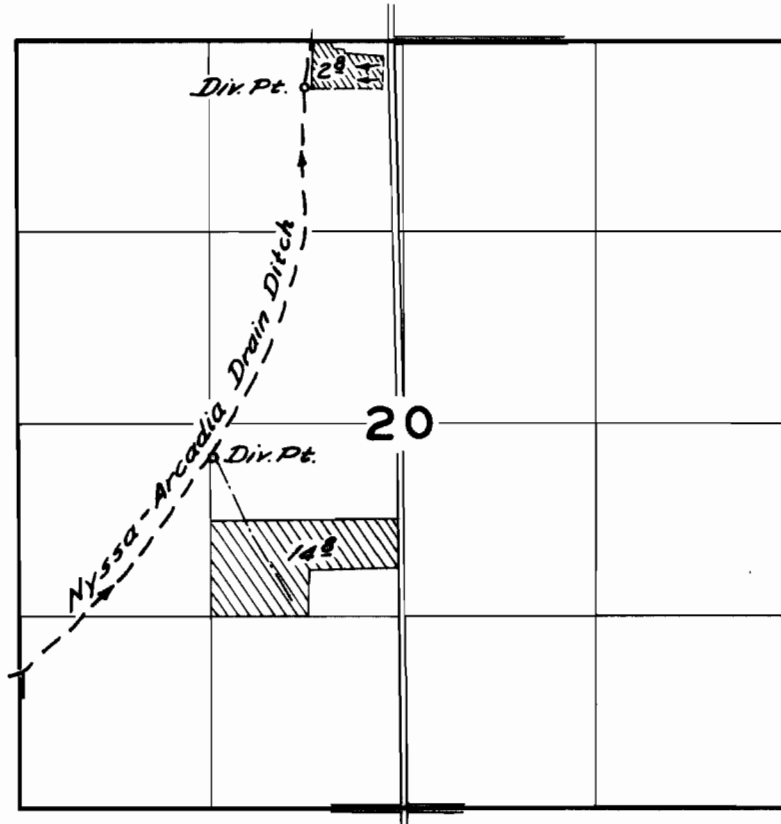

FINAL PROOF SURVEY
UNDER

Application No. 20045 Permit No. 15612
IN NAME OF

.....
Surveyed June 8 1960, by O. O. Baitle