


# T.8S.R.1W.W.M.

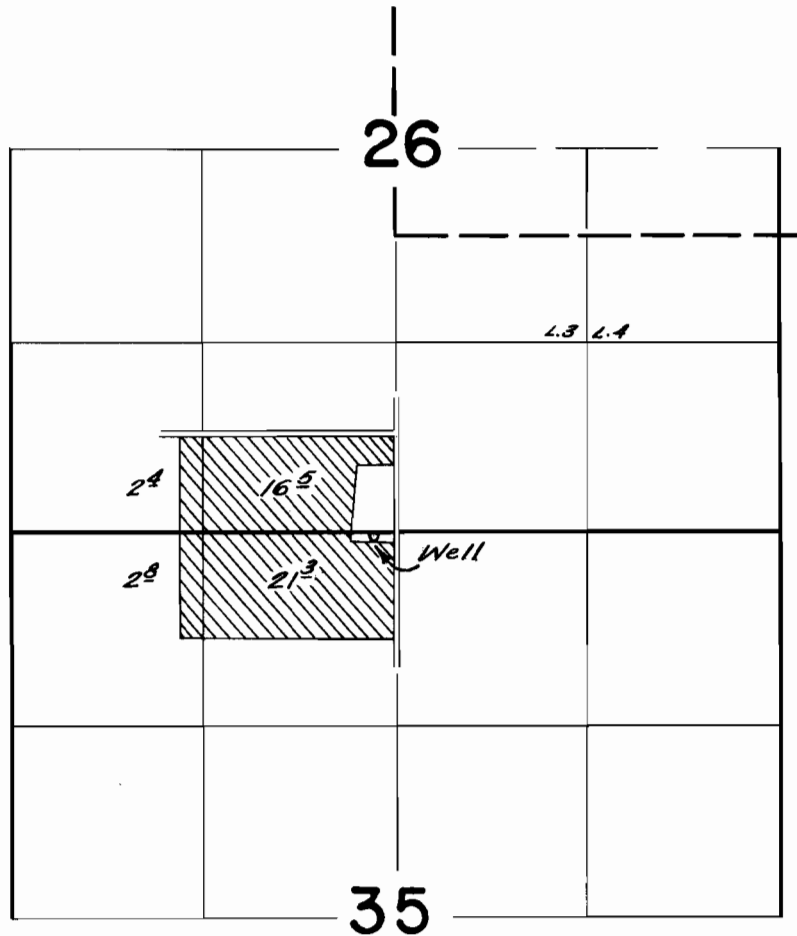

## FINAL PROOF SURVEY UNDER

Application No. *G-1338* Permit No. *G-1210*  
IN NAME OF

*Richard G. Schumacher*

Surveyed *April 27 1961*, by *Colburn*