


T.7S.R.1E.W.M.

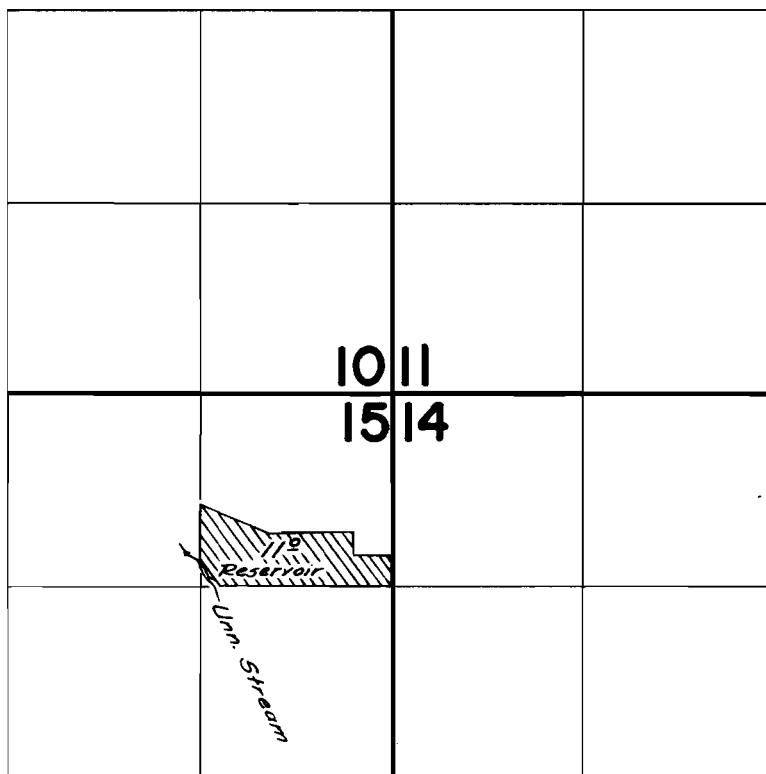

FINAL PROOF SURVEY
UNDER

Application No. *R-31887* *32138* Permit No. *R-2117* *25367*
IN NAME OF

FRANCIS W. POPE

Surveyed *June 16*, 1961, by *Co Bartels*