T.10 S.R.5 E.W.M.

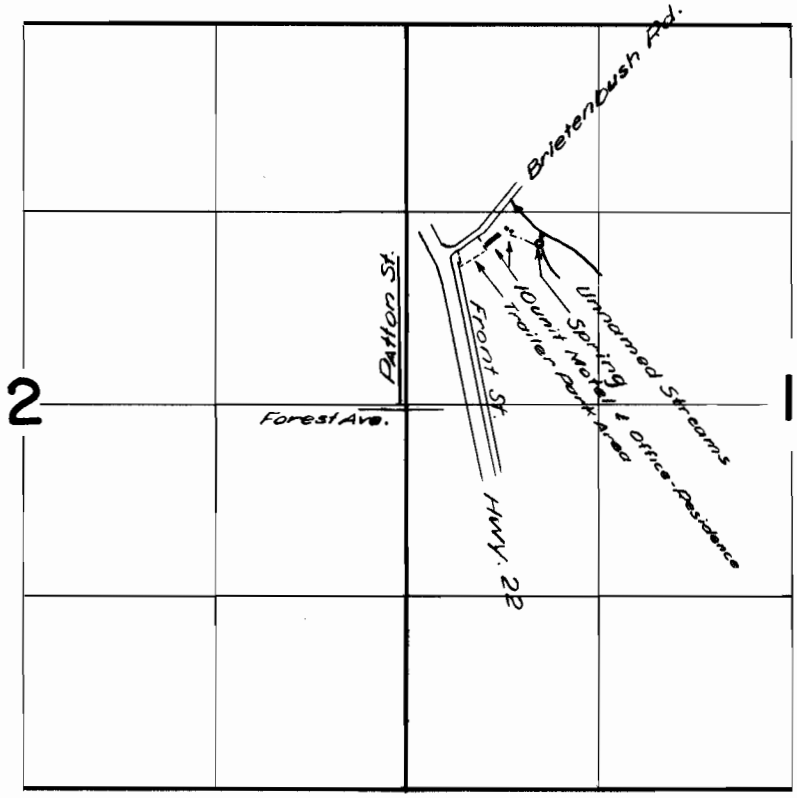

FINAL PROOF SURVEY
UNDER

Application No. 33295 Permit No. 26312
IN NAME OF

A.L. BARKER

Surveyed SJULY 1961, by M. Bish

1961-A
1957-D