


SECTION LINE



SECTION 34  
TWP 1N, R 1E, WM

SECTION LINE

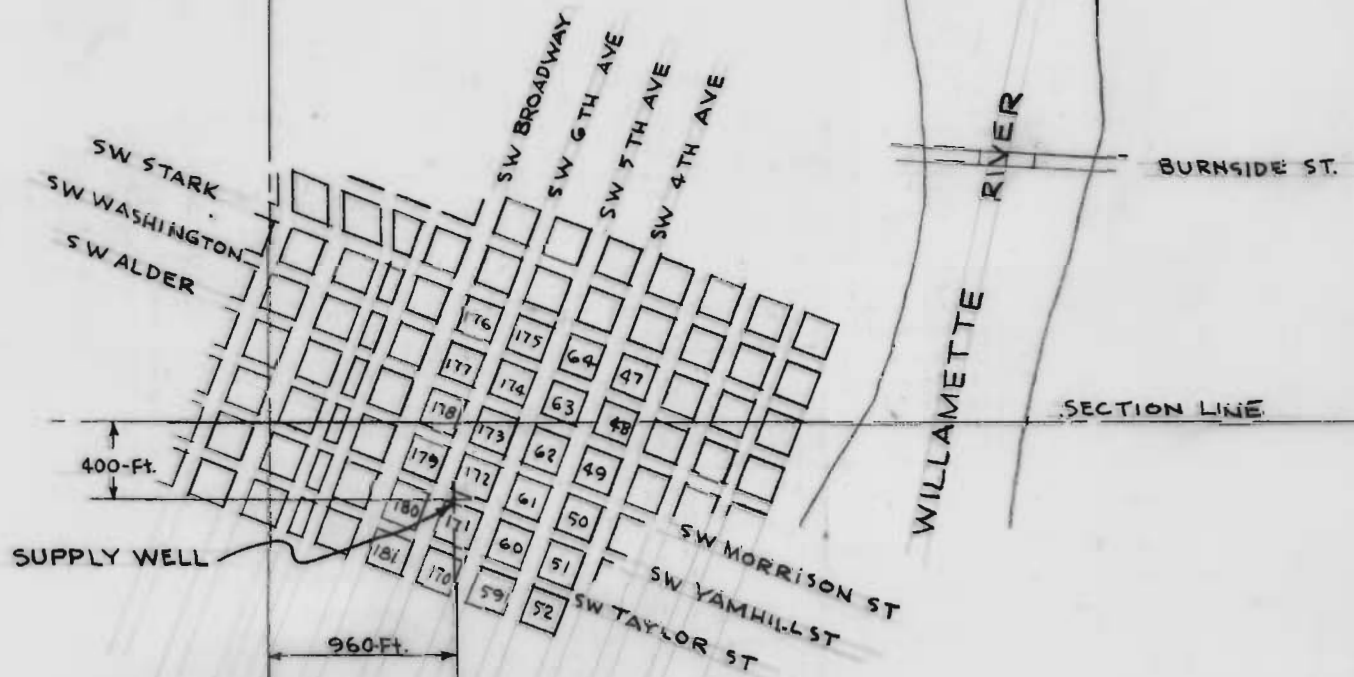

# LOCATION MAP SUPPLY WELL FOR

AIR CONDITIONING THE PACIFIC BUILDING  
LADD BUILDING CO., OWNERS

1" = 1000'

Application No. G-1337  
Permit No. G-1195



J. DONALD KROEKER  
AND ASSOCIATES  
CONSULTING ENGINEERS

1-19-59