


T.2N.R.2W.W.M.

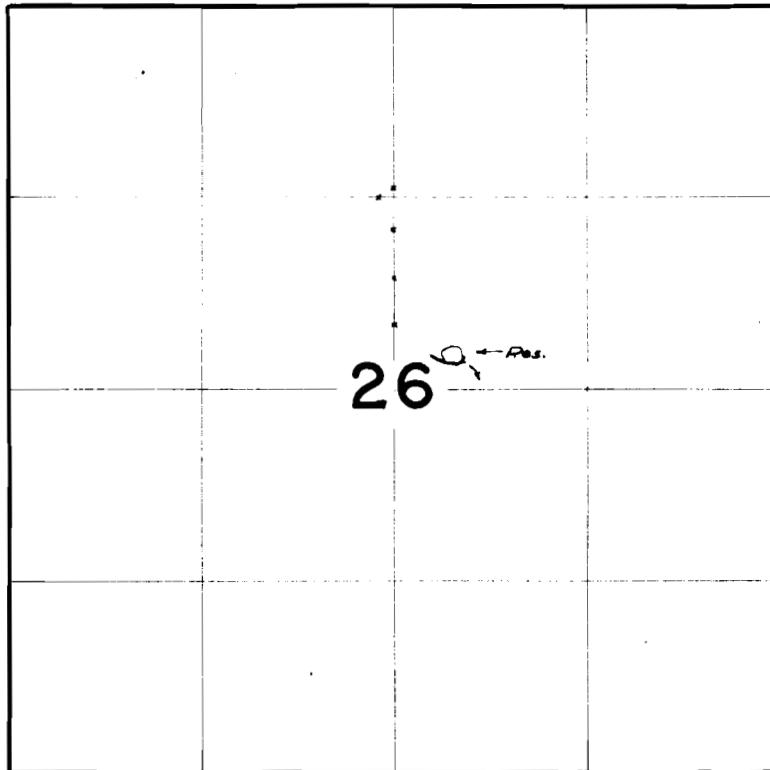

FINAL PROOF SURVEY
UNDER

Application No. ²⁶⁴⁸⁶~~P-26485~~ Permit No. ²⁰⁷⁵⁹~~P-1260~~
IN NAME OF

EDWARD T. FOLKENBERG

Surveyed 24 JULY 1961, by M. Bish