


T.I.S.R. 4 E.W.M.

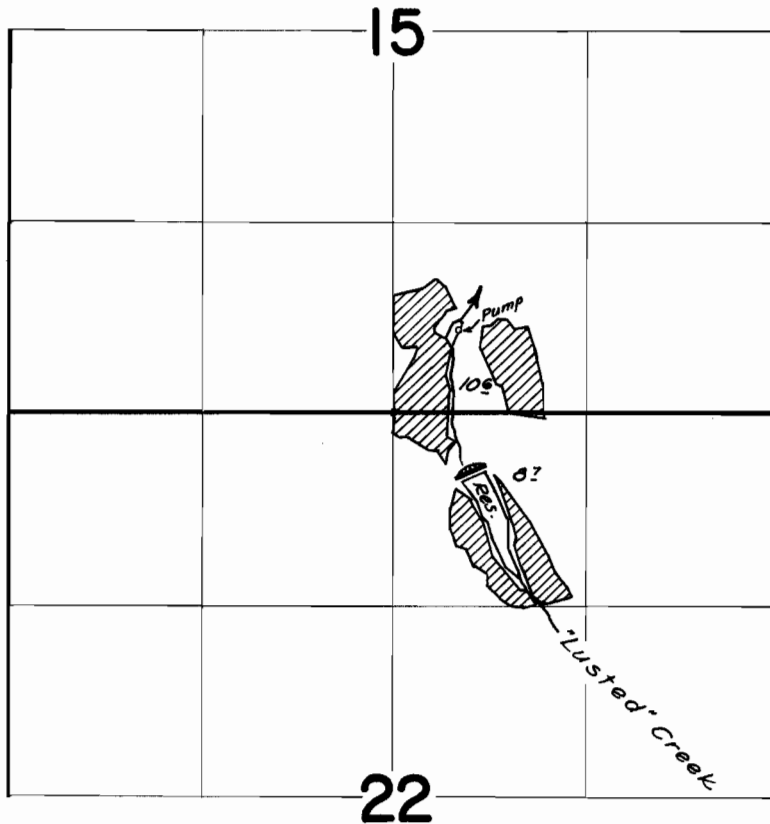

FINAL PROOF SURVEY
UNDER

R-27675 R-1498
Application No. 27676 Permit No. 22346
IN NAME OF

SAMUEL L. DIACK, M.D.

Surveyed August 17 1961, by C.O. Bartels