


T.I.S.R.I.E.W.M.

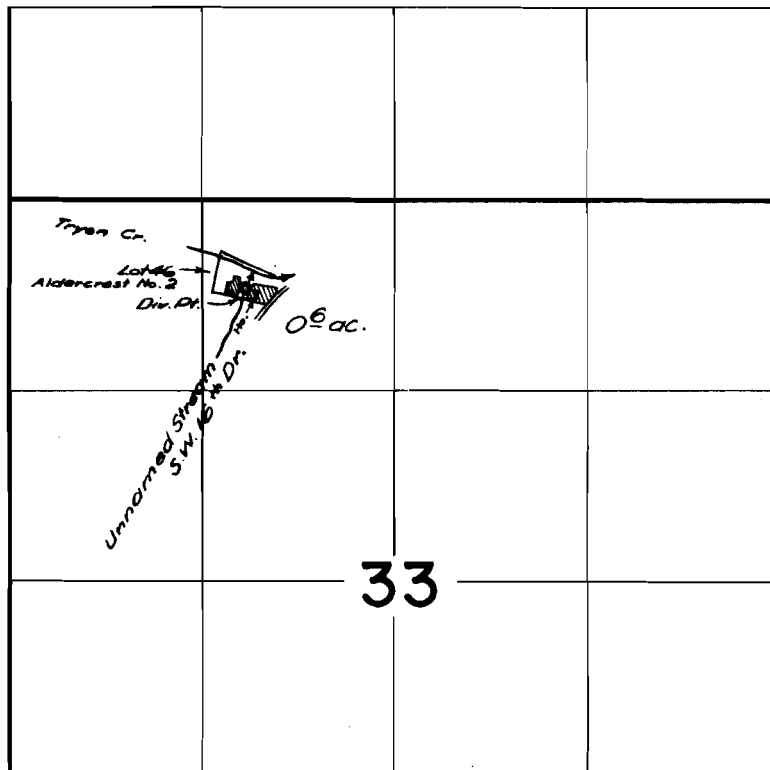

FINAL PROOF SURVEY UNDER

Application No. 33433 Permit No. 26453
IN NAME OF

ADOLPH & OLGA HAAS

Surveyed 24 JULY 1961, by Tr. B. Beahm