


T.I.N.R.I.W.W.M.

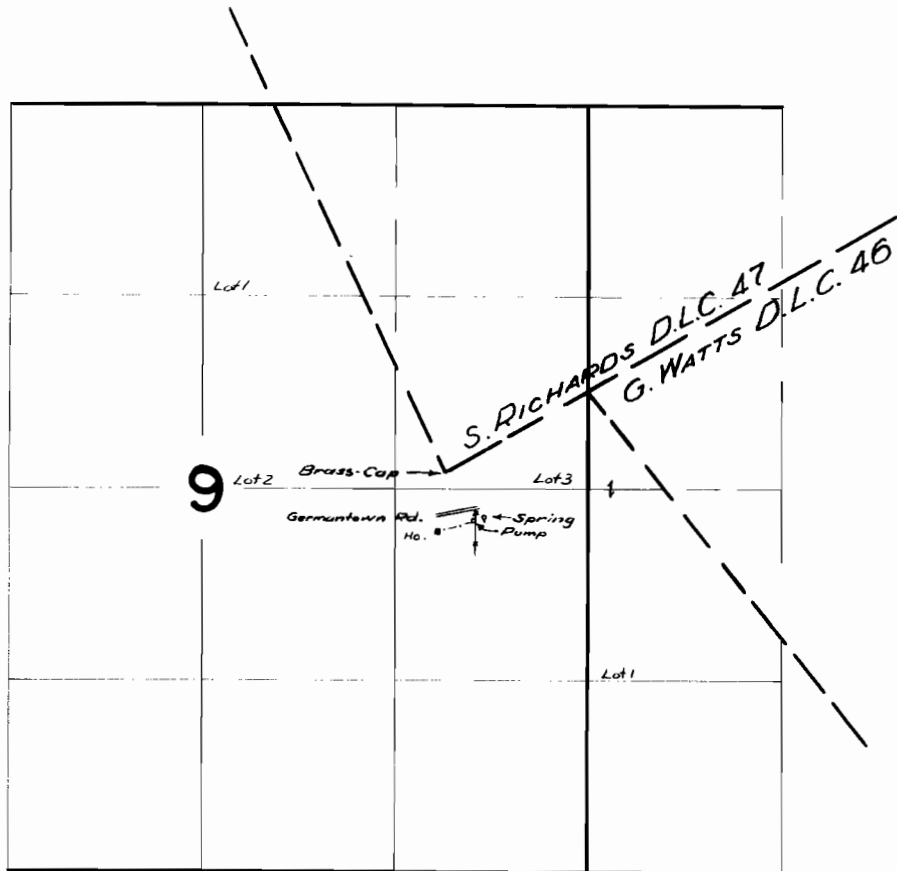

FINAL PROOF SURVEY UNDER

Application No. 34566 Permit No. 27148
IN NAME OF

HAROLD A. JOHNSON

Surveyed 25 JULY 1961 by m. Bish