


T. 9S.R. 6W.W.M.

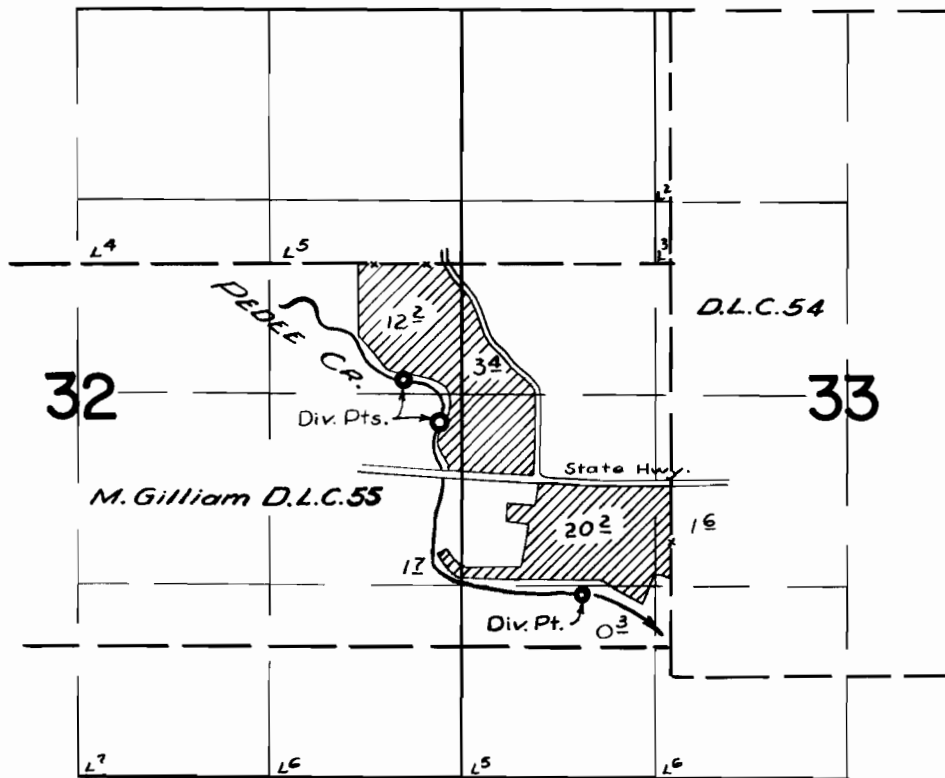

FINAL PROOF SURVEY UNDER

Application No. 22574 Permit No. 17915
IN NAME OF

SIDNEY HOWARD & FLORENCE LACY HOWARD

Surveyed 6 Sept. 1961, by M. B. Besh