


# T. 9 S. R. 5 W. W. M.

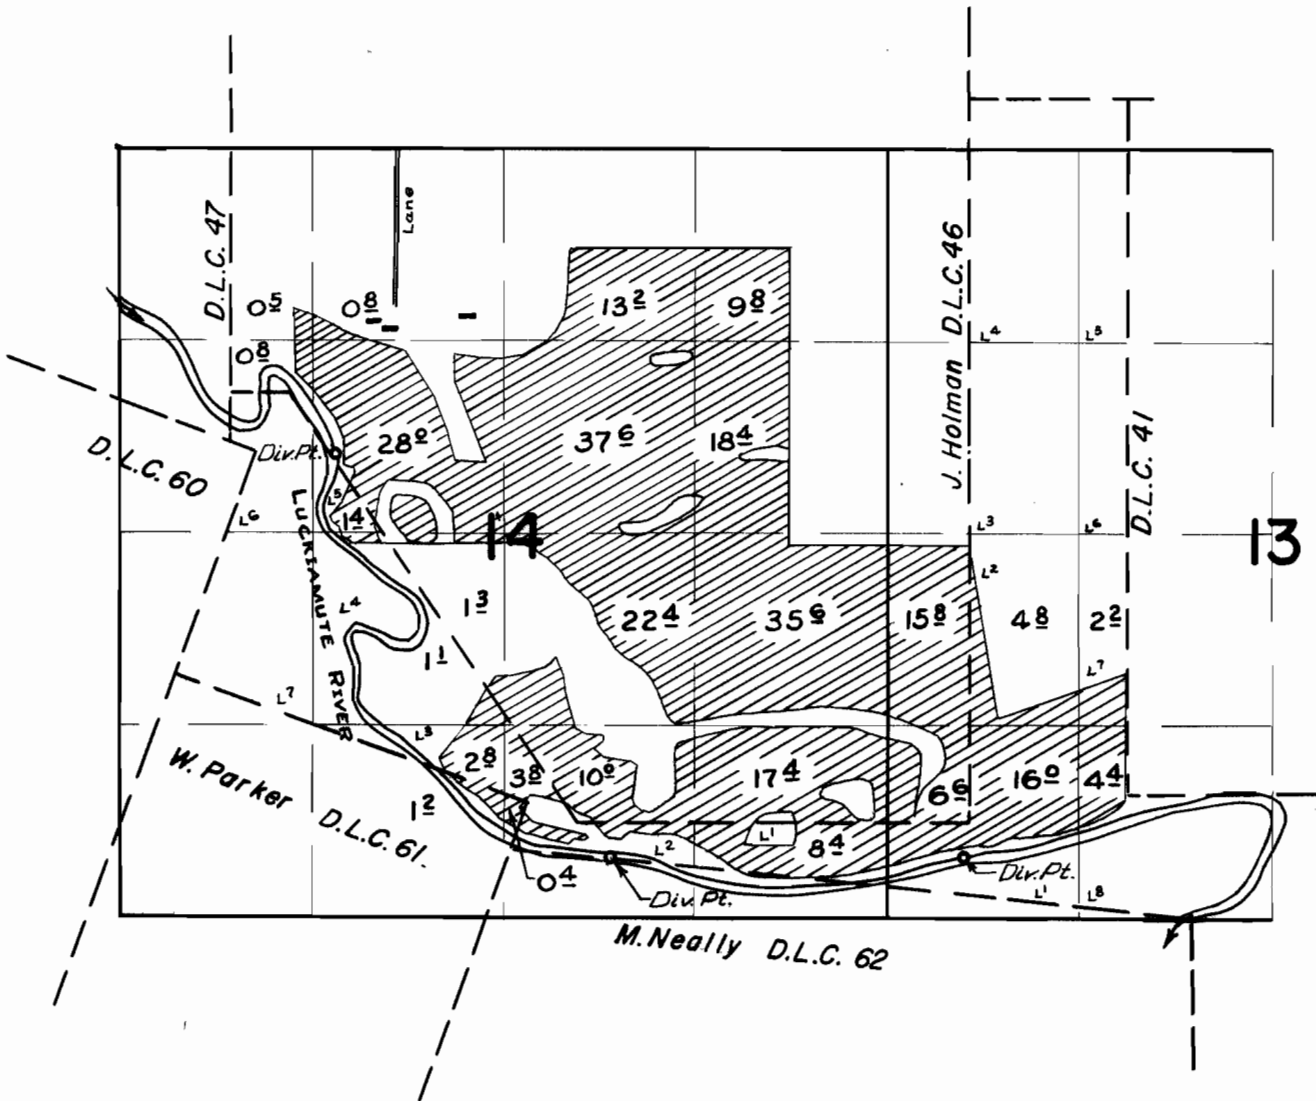

## FINAL PROOF SURVEY UNDER

Application No. 29231 Permit No. 22955  
IN NAME OF

HAROLD E. MCKAY

Surveyed 3 April 1961, by M. Bishop