


T. 1 N. R. 7 W. W. M.

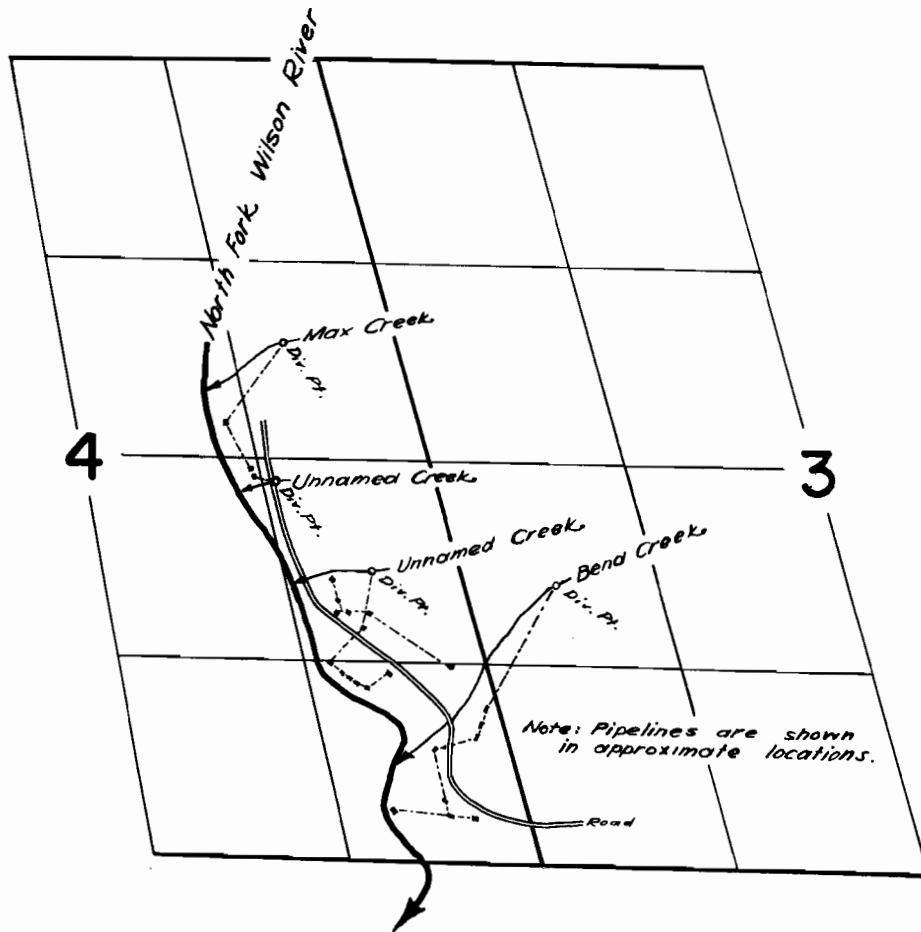

FINAL PROOF SURVEY UNDER

Application No. **31326** Permit No. **24785**
IN NAME OF

REEHER'S INC.

Surveyed August 10 1961, by

[Handwritten Signature]