


T. 3 S. R. 10 W. W.M.

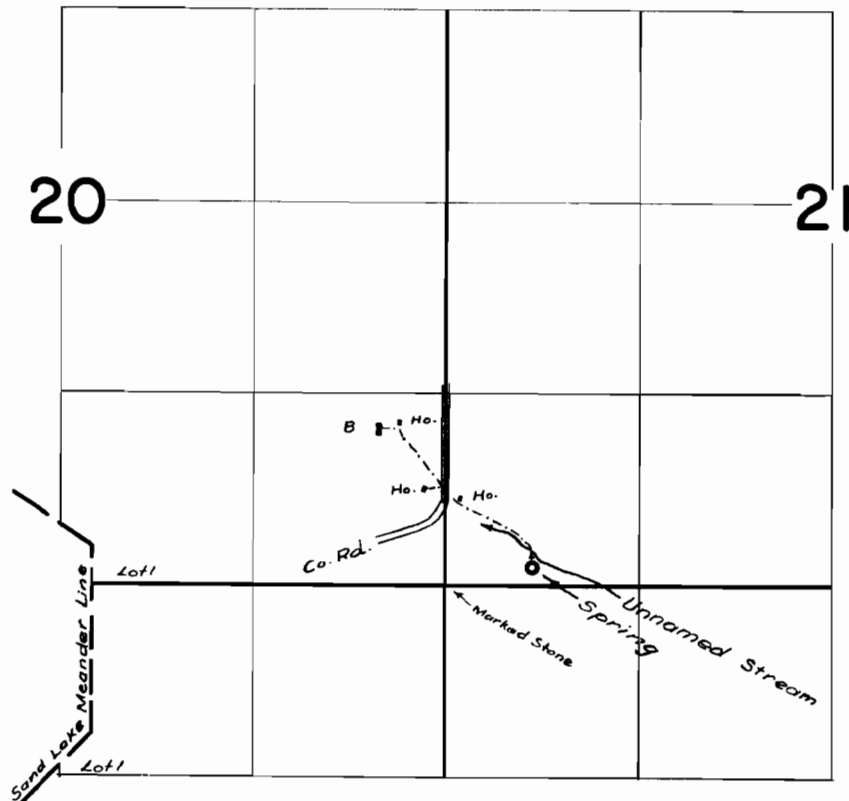

FINAL PROOF SURVEY
UNDER

Application No. 32887 Permit No. 25970
IN NAME OF

Joe O. Chatelain

Surveyed 29 JUNE 1961, by M. B. B.