


G-706
29716

Application No. G-795
Permit No. G-706

NW 1/4 QUARTER N.E. QUARTER 34 SECTION 34

1320

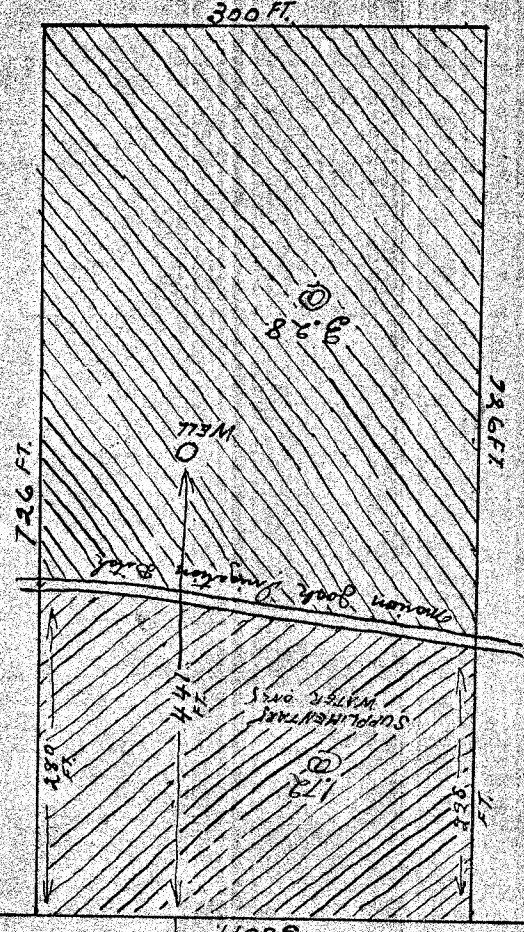

1320

WEST