


T. 1 N. R. 3 W. W. M.

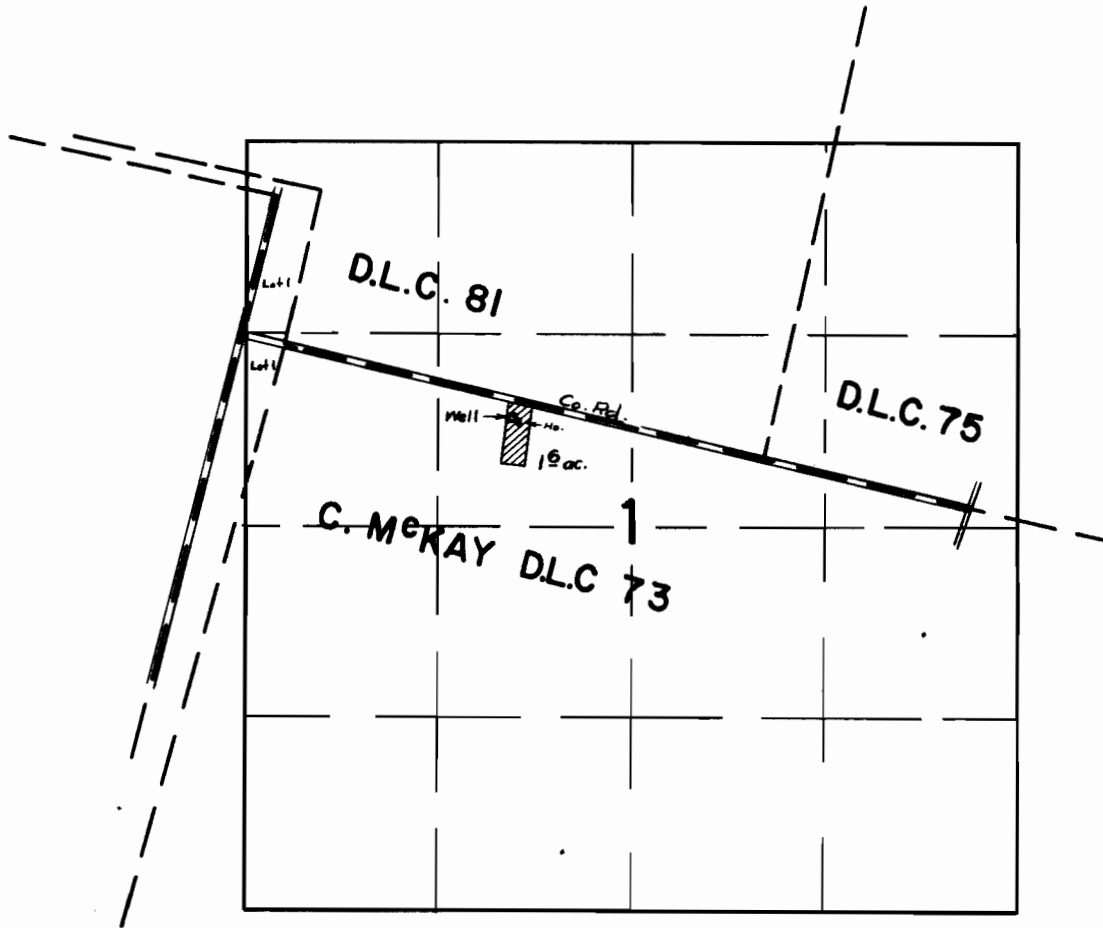

**FINAL PROOF SURVEY**  
UNDER

Application No. G-1119 Permit No. G-983  
IN NAME OF

LEONID W. VOELKER

Surveyed 14 AUG. 1961, by M. Bish