


T.2S.R.1W.W.M.

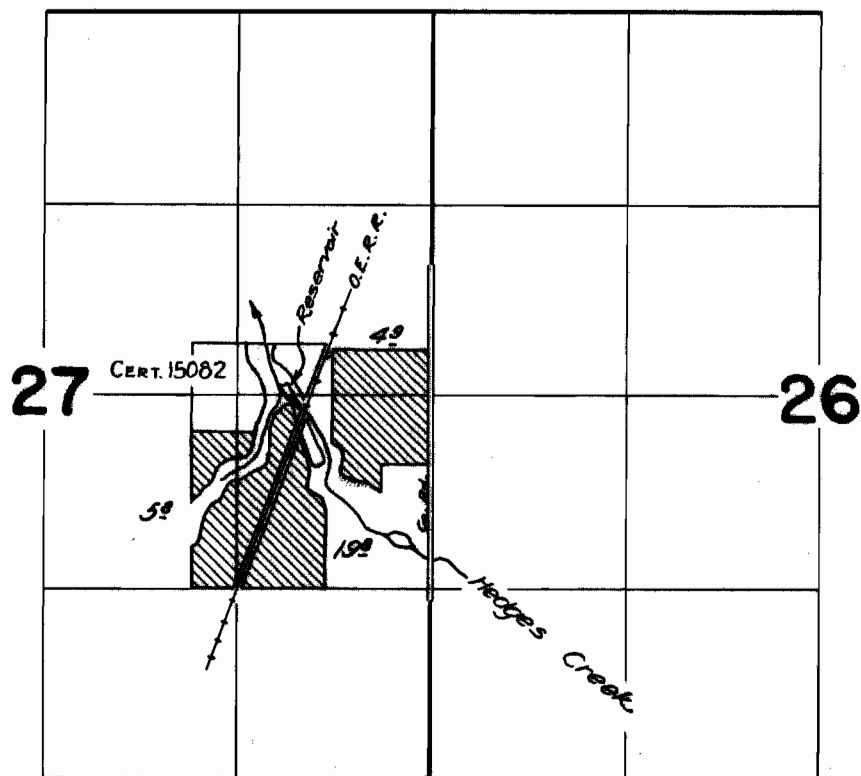

FINAL PROOF SURVEY UNDER

Application No. **R-29646** ~~29647~~ Permit No. **R-1705** ~~23346~~
IN NAME OF

ROBERT J. GRAVES

Surveyed *June 22* 1961, by *[Signature]*