


T.2N.R.4W.W.M.

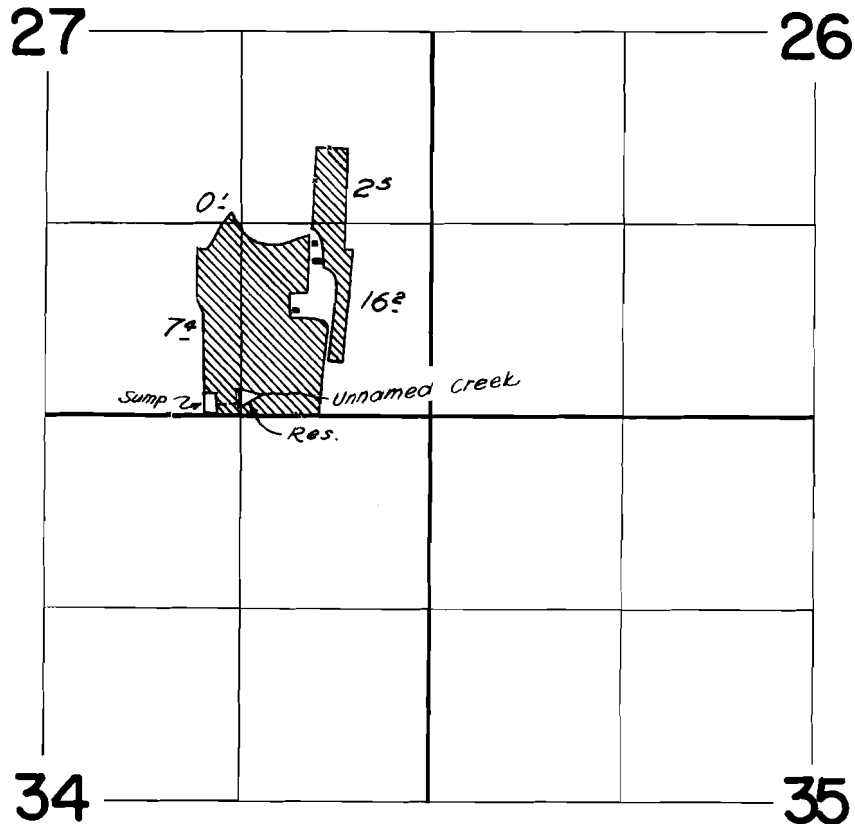

FINAL PROOF SURVEY  
UNDER

R-30231                      R-1795  
Application No. 30232 Permit No. 23833  
IN NAME OF

EARL and ISLA GENZER

Surveyed July 25 1961, by *R. Jackson*