


T.2N.R.4W.W.M.

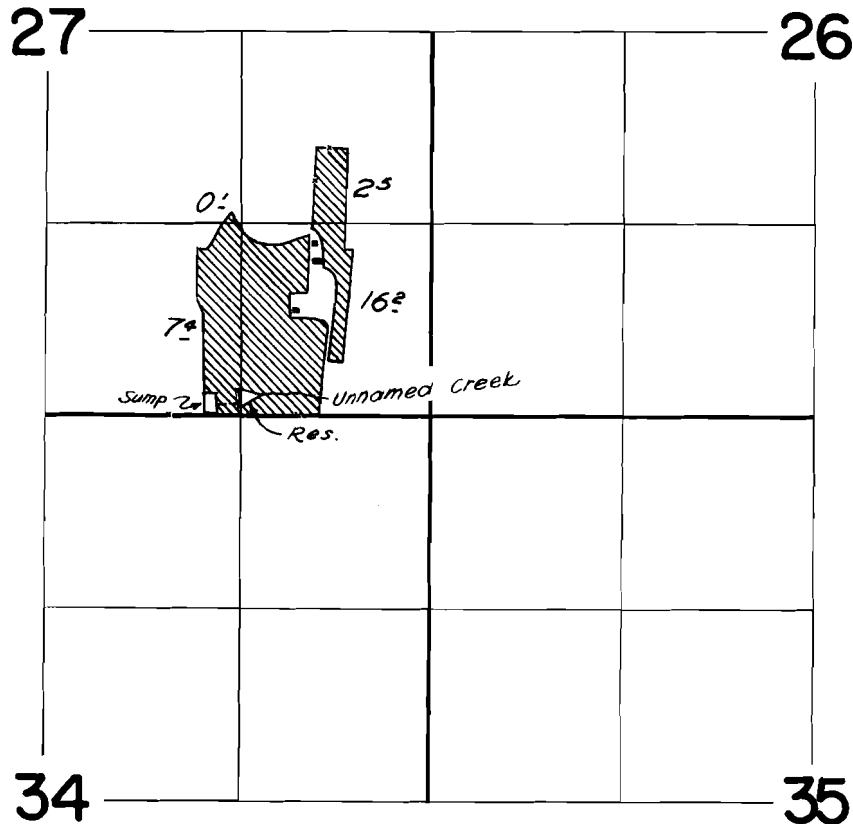

FINAL PROOF SURVEY
UNDER

R-30231 R-1795
Application No. 30232 Permit No. 23833
IN NAME OF

EARL and ISLA GENZER

Surveyed July 25 1961, by *R. Jackson*