


T.2N.R.4W.W.M.

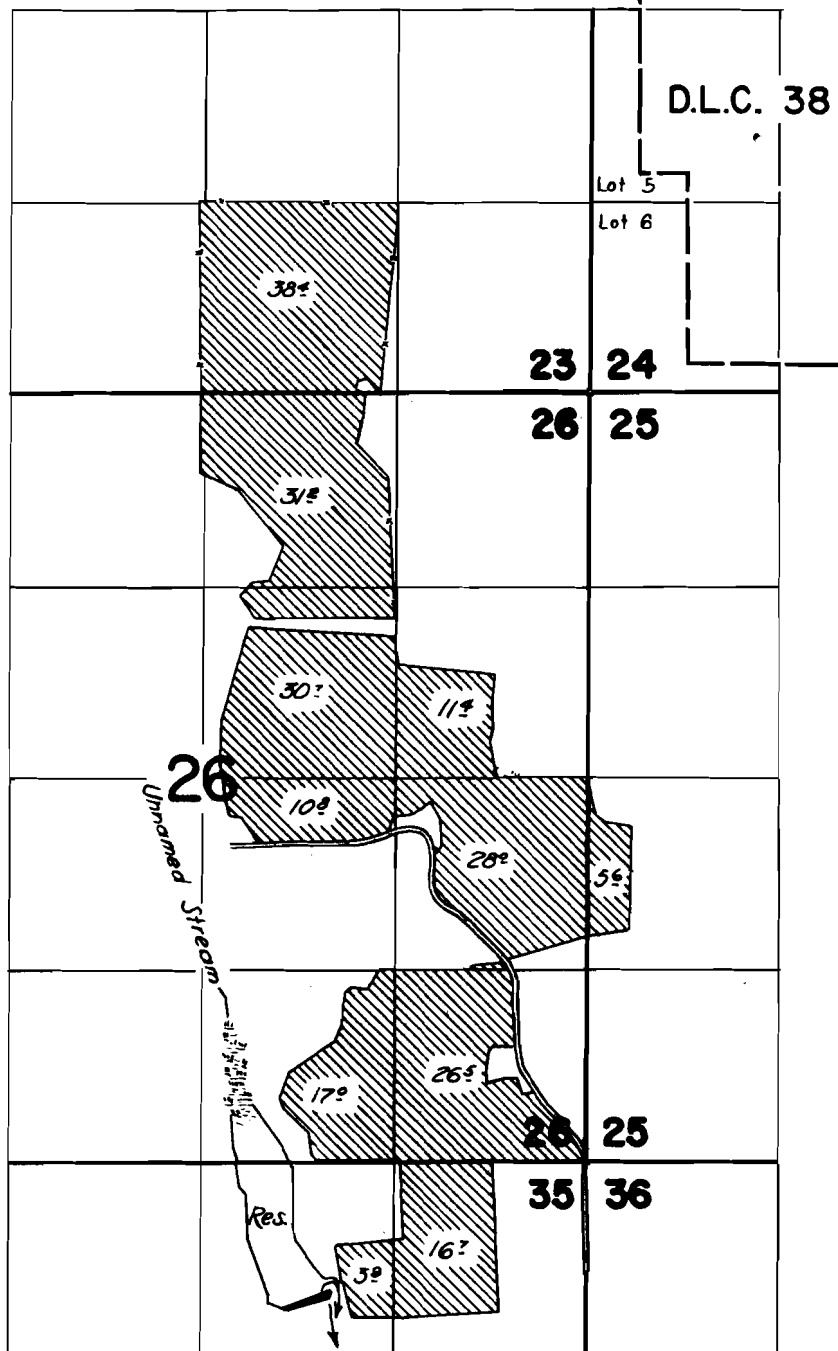

FINAL PROOF SURVEY
UNDER

R-30747 R-1869
Application No. 30748 Permit No. 24224
IN NAME OF

HOLLIS HARTWICK

Surveyed July 26, 27, 28 1961, by *R. Jackson*