


# T. 1 S. R. 2 W. W. M.

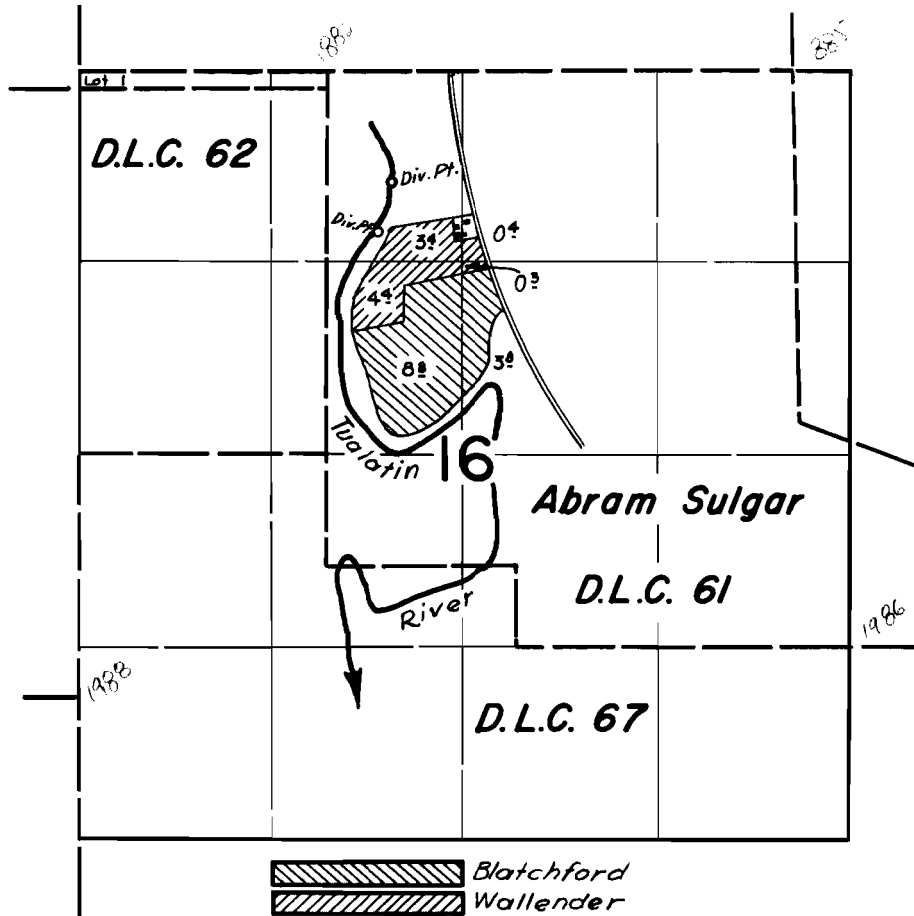

## FINAL PROOF SURVEY UNDER

Application No. **31250** Permit No. **24622**

IN NAME OF  
**LENNOX BLATCHFORD**  
**FRED WALLENDER**

Surveyed *June 21, 1960*, by *[Signature]*  
& *August 9, 1961*