


T.2N.R.3W.W.M.

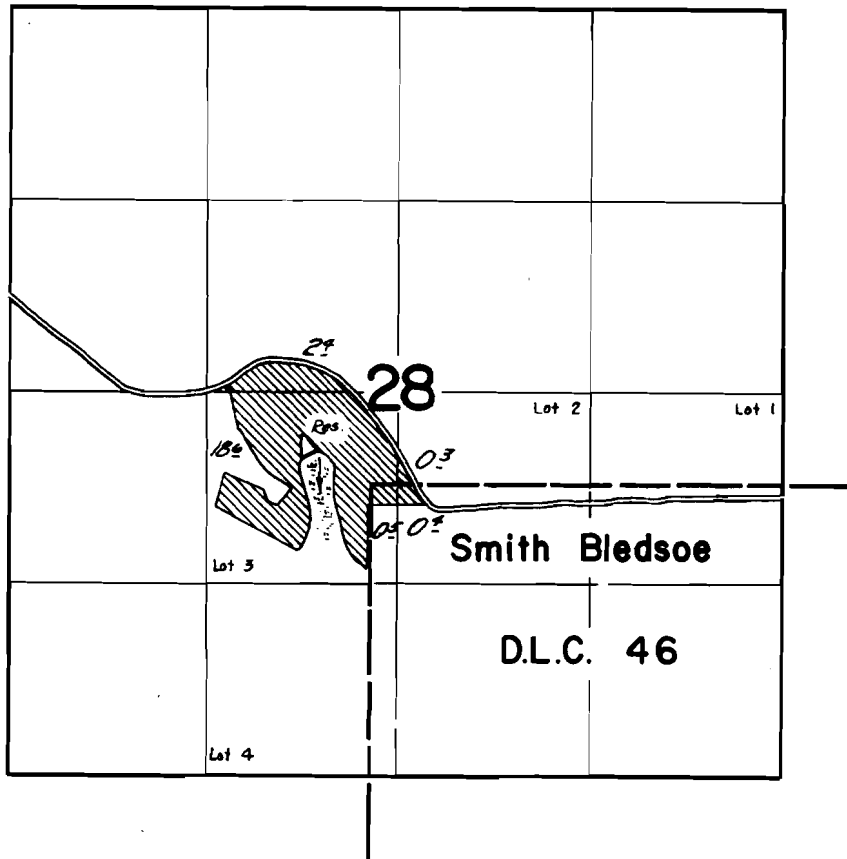

FINAL PROOF SURVEY
UNDER

Application No. **R-31243** **31244** Permit No. **R-1993** **24719**
IN NAME OF

WILLIAM VERNON HAHN

Surveyed *July 24 1961* by *R. Jackson*