


T.2N.R.3W.W.M.

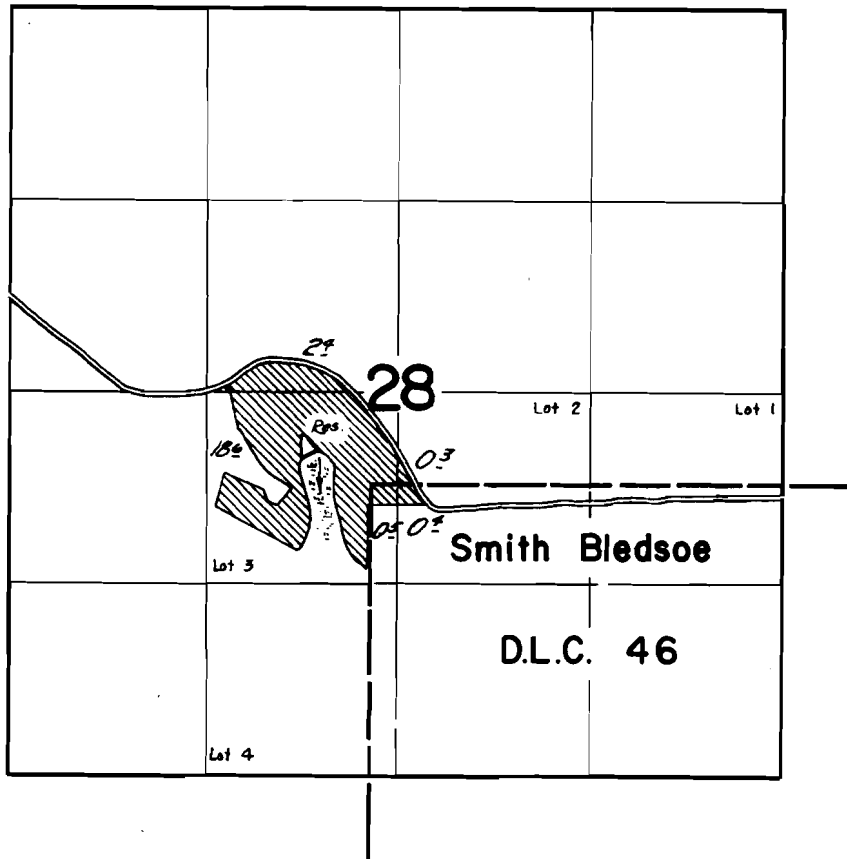

FINAL PROOF SURVEY
UNDER

R-31243 R-1993
Application No. 31244 Permit No. 24719
IN NAME OF

WILLIAM VERNON HAHN

Surveyed July 24 1961 . by *R. Jackson*