


T. 1 S. R. 2 W. W. M.

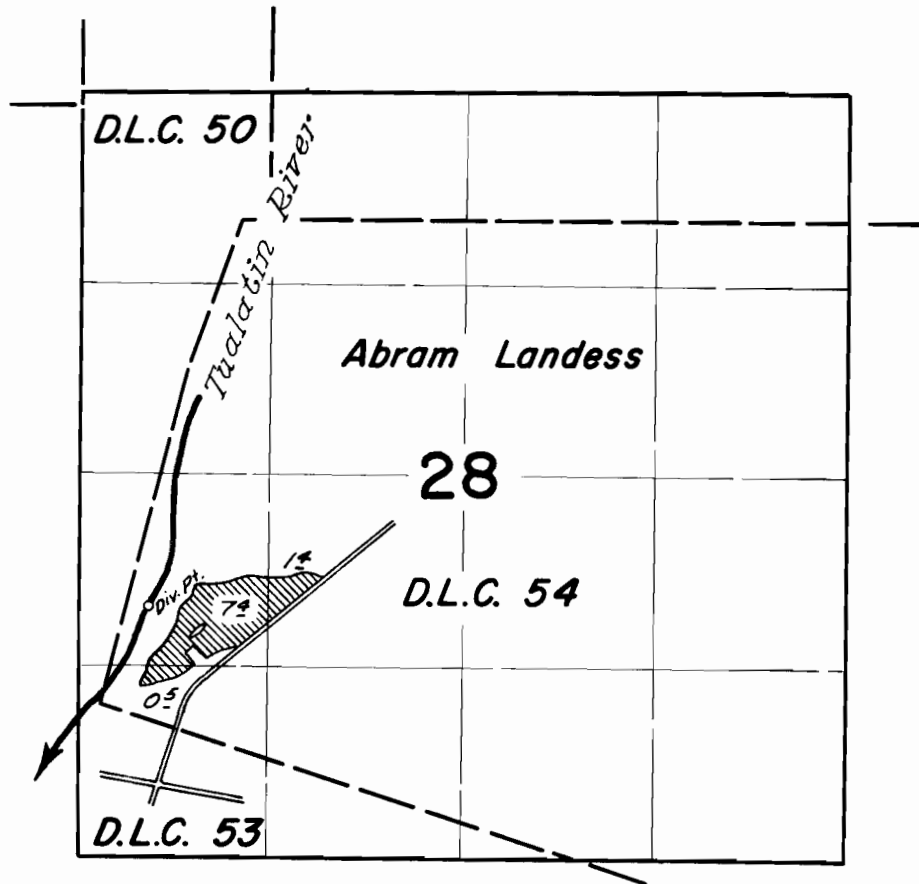

**FINAL PROOF SURVEY**  
UNDER

Application No. **31402** Permit No. **24753**  
IN NAME OF

**DAVID LAYTON WATTS**

Surveyed August 9 1961, by *A. Jackson*