


# T.I.S.R.I.W.W.M.

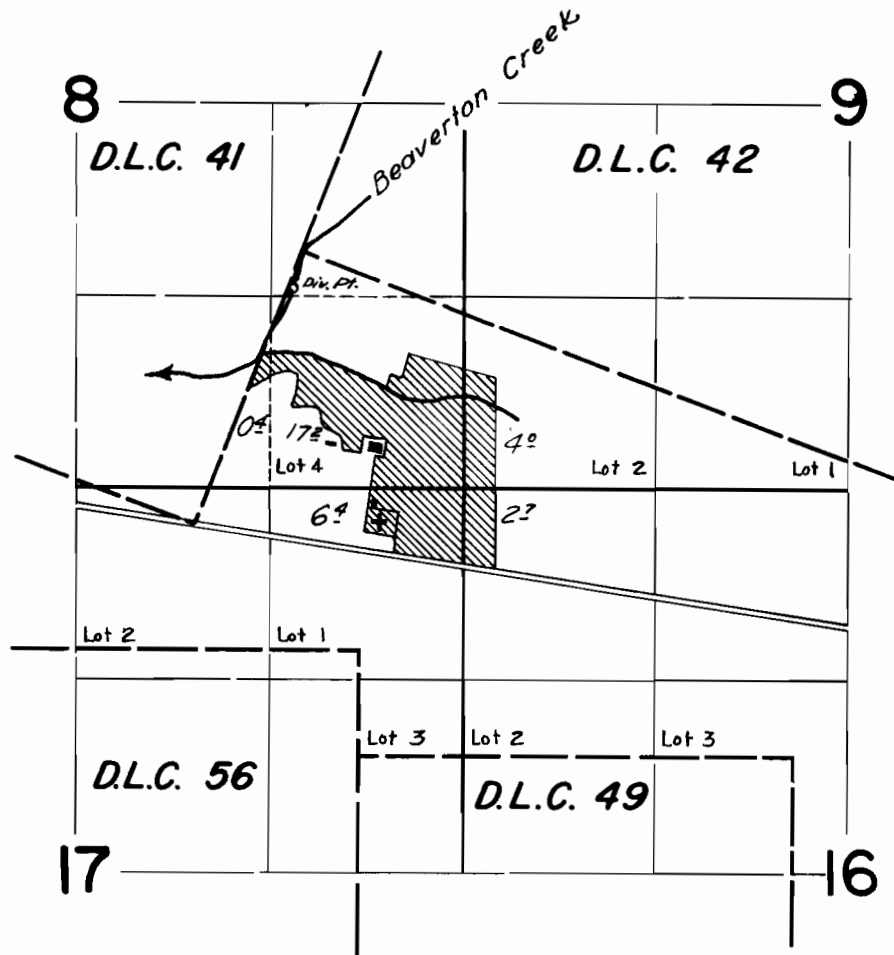

## FINAL PROOF SURVEY UNDER

Application No. **31404** Permit No. **24755**  
IN NAME OF

**SISTERS OF ST. MARY, INC.**

Surveyed *June 21, 1961*, by *[Signature]*