


T.2 N.R. 3 W.W.M.

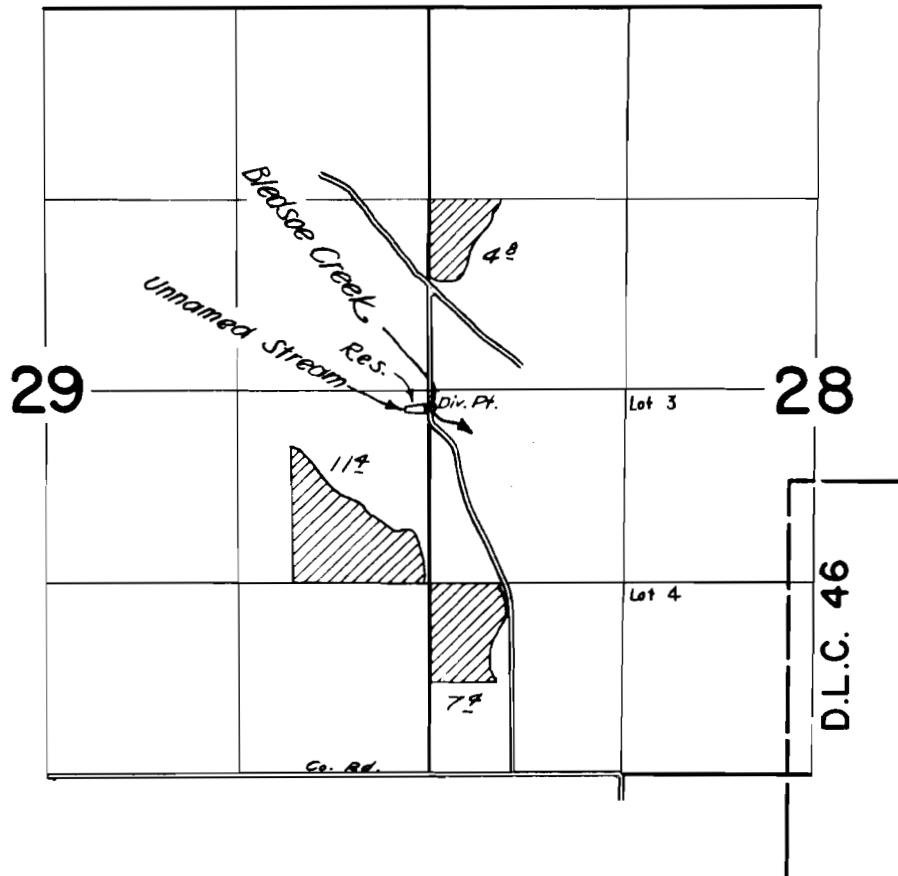

FINAL PROOF SURVEY  
UNDER

R-31410                      R-2009  
Application No. 31411      Permit No. 24836  
IN NAME OF

SCHLEGEL BROTHERS

Surveyed August 16 1961, by *R. H. Jackson*