


T.2 N.R. 3 W.W.M.

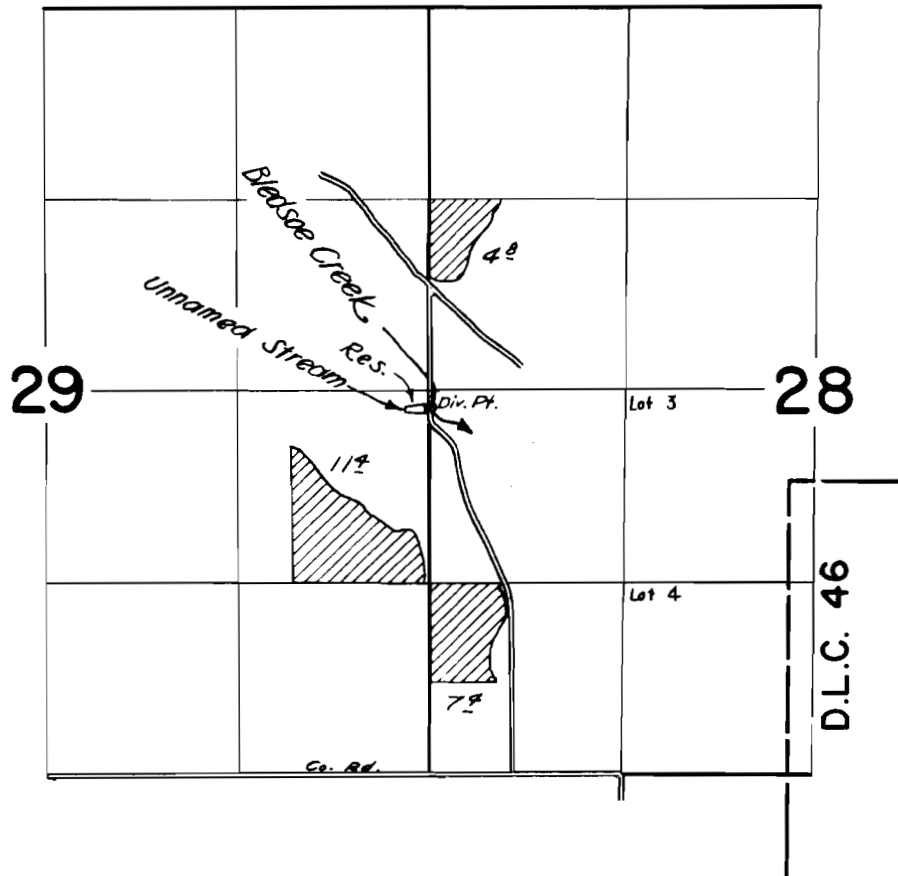

FINAL PROOF SURVEY
UNDER

R-31410 R-2009
Application No. 31411 Permit No. 24836
IN NAME OF

SCHLEGEL BROTHERS

Surveyed August 16 1961, by *R. H. Jackson*