


T.IN.&IS.R.2W.W.M.

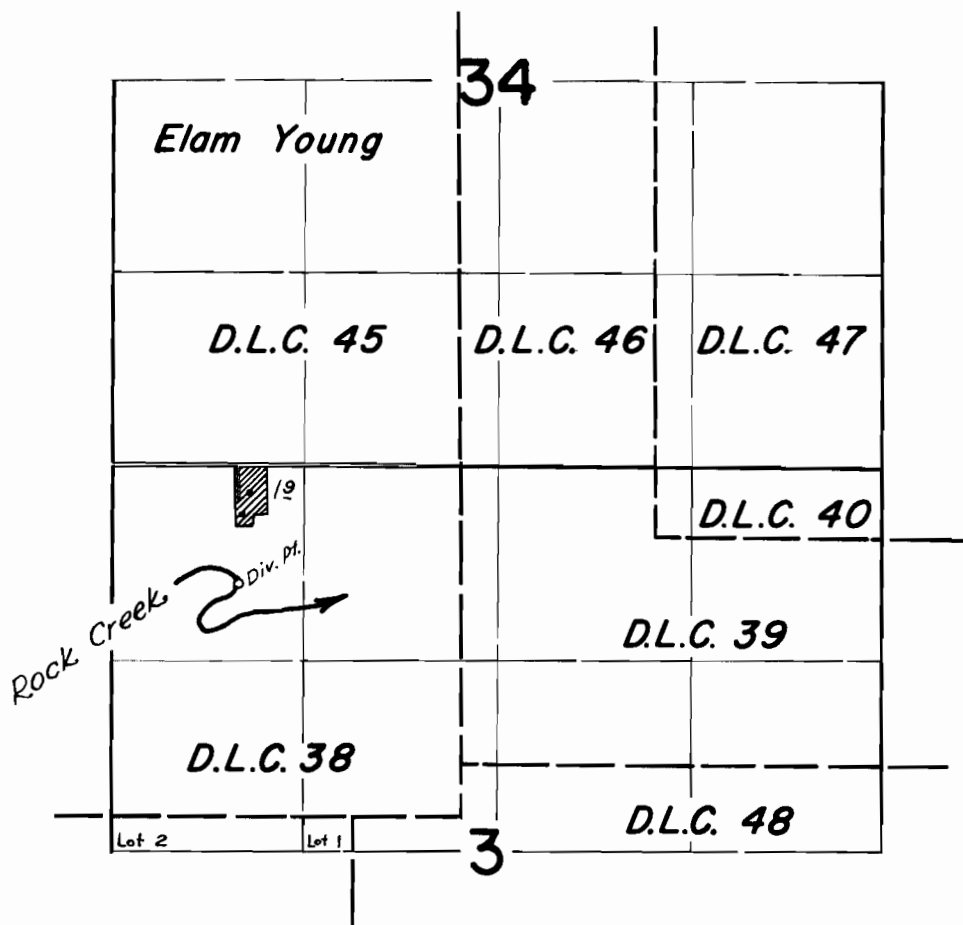

FINAL PROOF SURVEY UNDER

Application No. **32217** Permit No. **25420**
IN NAME OF

CHARLES V. WAHLBERG

Surveyed August 9 1961, by *R. Johnson*