


T. I. S. R. I. W. W. M.

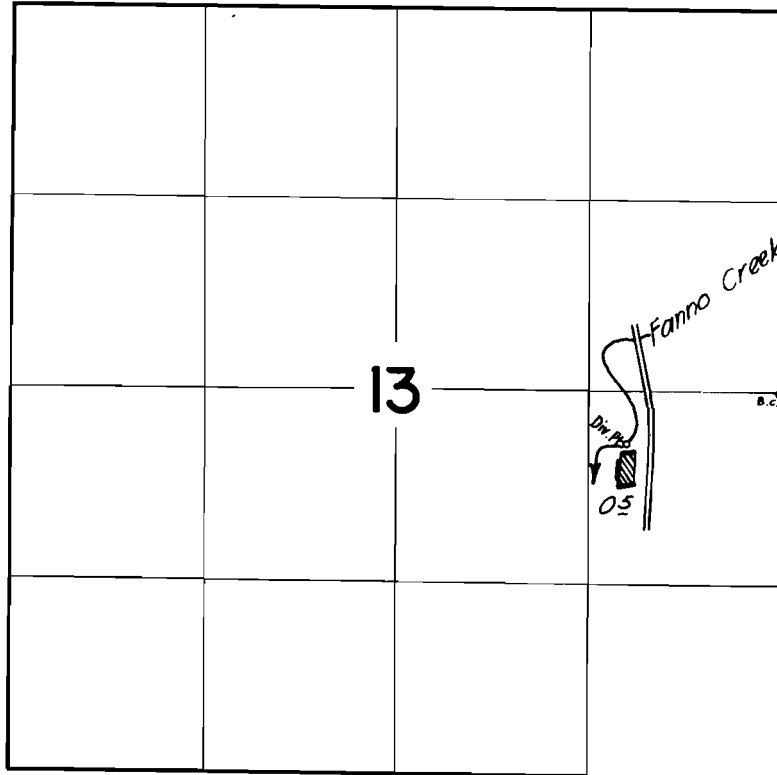

FINAL PROOF SURVEY UNDER

Application No. **32632** Permit No. **25740**
IN NAME OF

DEL-RAY INC.

Surveyed *June 20* 1961, by *R. Jackson*