


T.2N.R.4&5W.W.M.

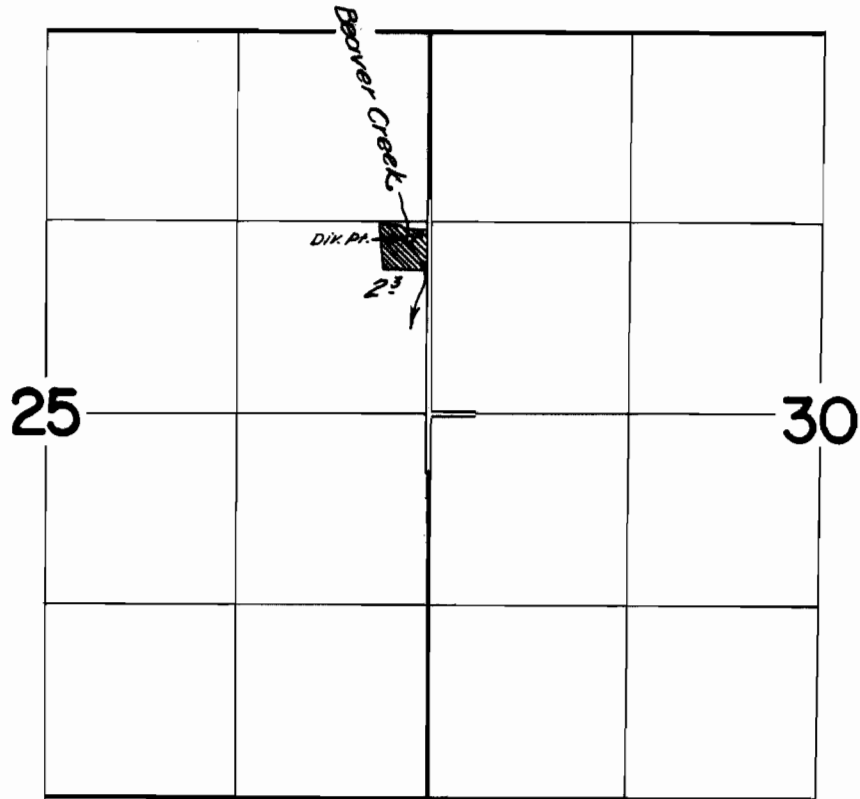

FINAL PROOF SURVEY  
UNDER

Application No. **32936**... Permit No. **26029**..  
IN NAME OF

**CECIL B. & LOUISE GRAHAM**

Surveyed *July 28, 1961*, by *R. Jackson*