


T. 1 S. R. 2 W. W. M.

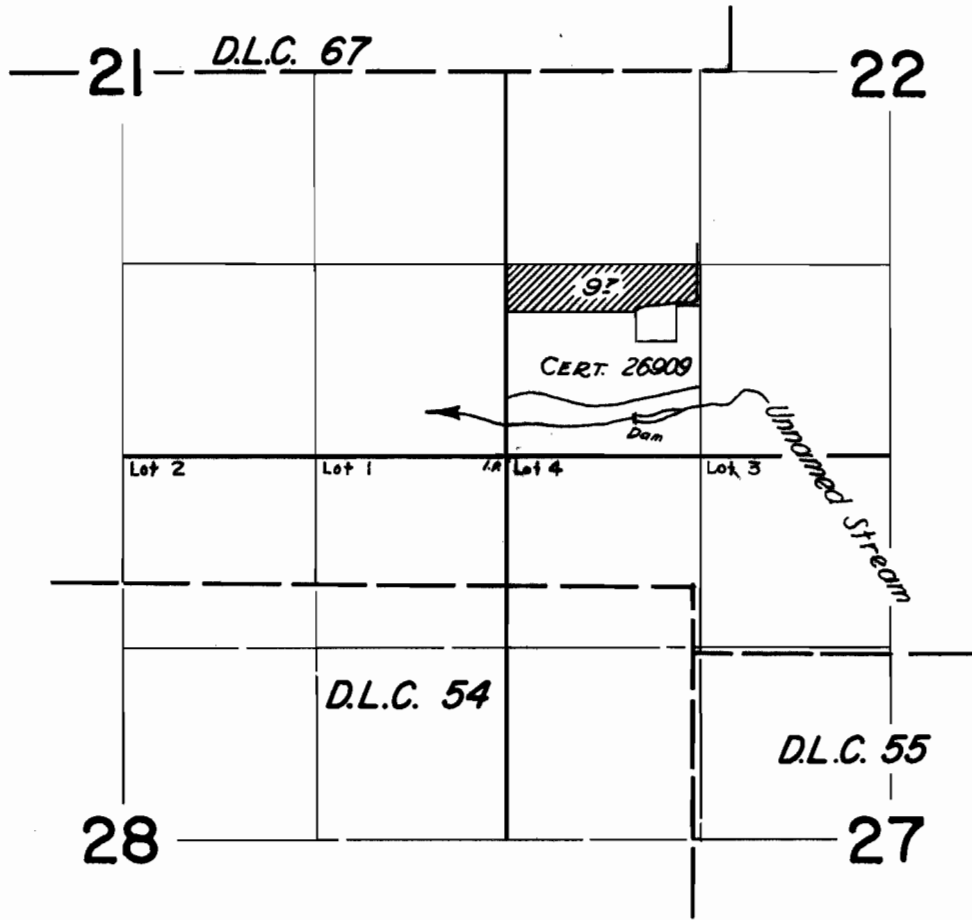

FINAL PROOF SURVEY
UNDER

Application No. 33128 Permit No. 26199
IN NAME OF

ELDON LLOYD WILLIAMSON

Surveyed August 2 1961, by [Signature]