


T.1S. R.3W. W.M.

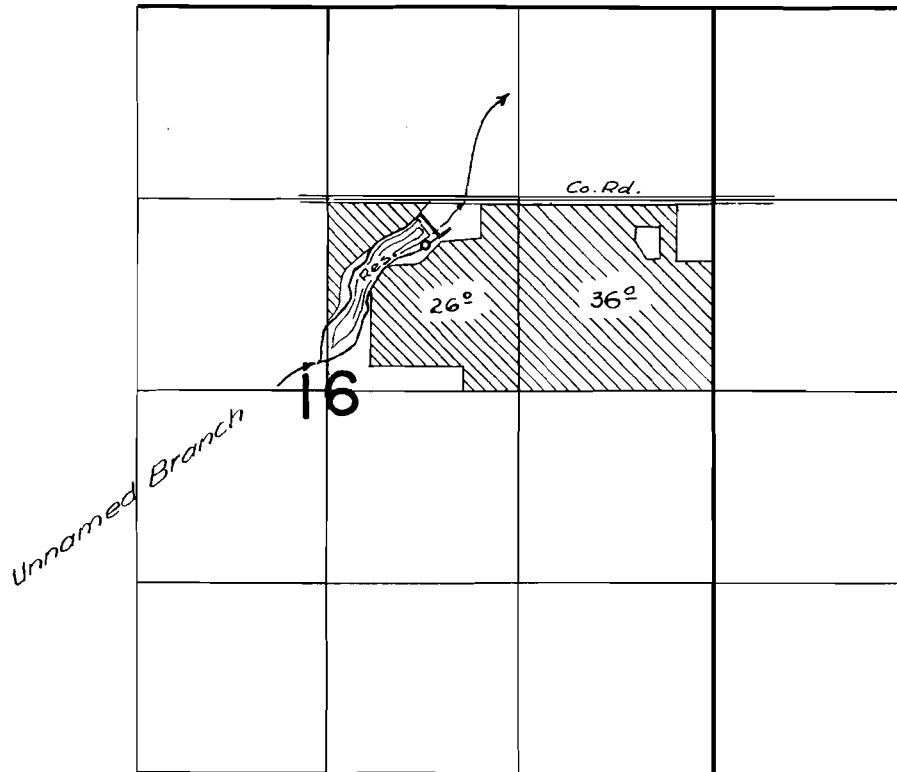

FINAL PROOF SURVEY
UNDER

Application No. ³³⁵²¹ ~~P-33520~~ Permit No. ²⁶⁵¹¹ ~~P-2312~~
IN NAME OF

CARLTON NURSERY

Surveyed 9 AUG. 1961, by m. Bish