


T. 1 S. R. 2 W. W. M.

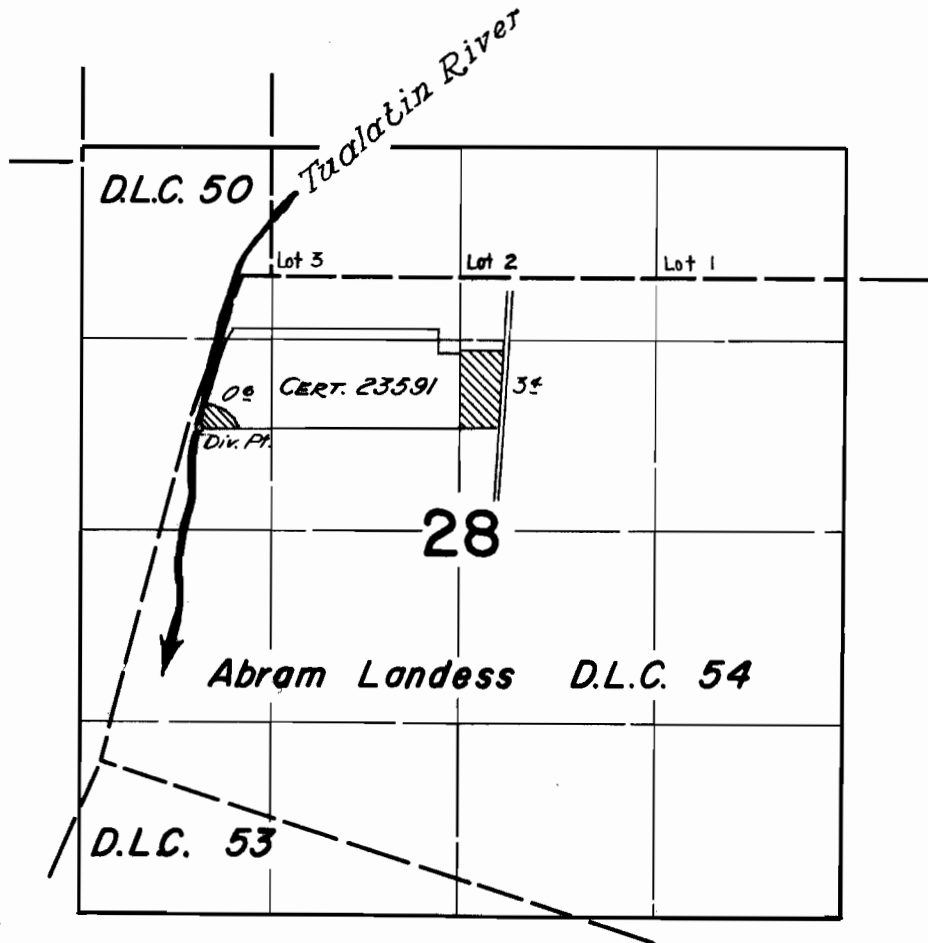

FINAL PROOF SURVEY UNDER

Application No. **33768** Permit No. **26661**
IN NAME OF

JOSEPH EDWARD O'MEARA

Surveyed *August 15*, 1961, by *[Signature]*