


# T. 39 S. 7 E. W.M.

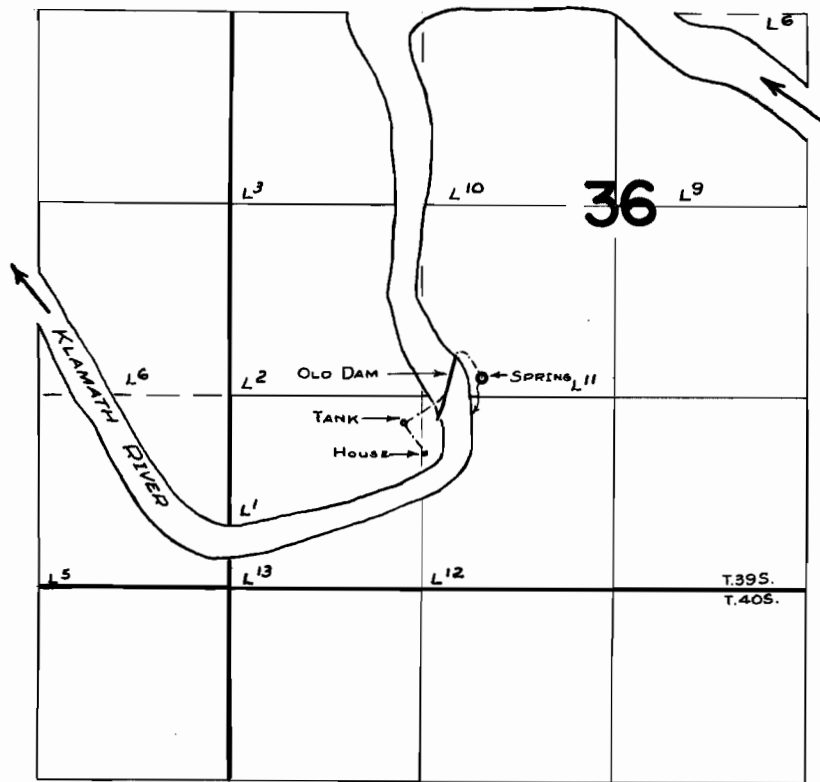

## FINAL PROOF SURVEY UNDER

Application No. 17696 Permit No. 26176  
IN NAME OF

CALIFORNIA OREGON POWER

Surveyed 18 APRIL 1961, by m. Bish