


T.15S.R. 5W.W.M.

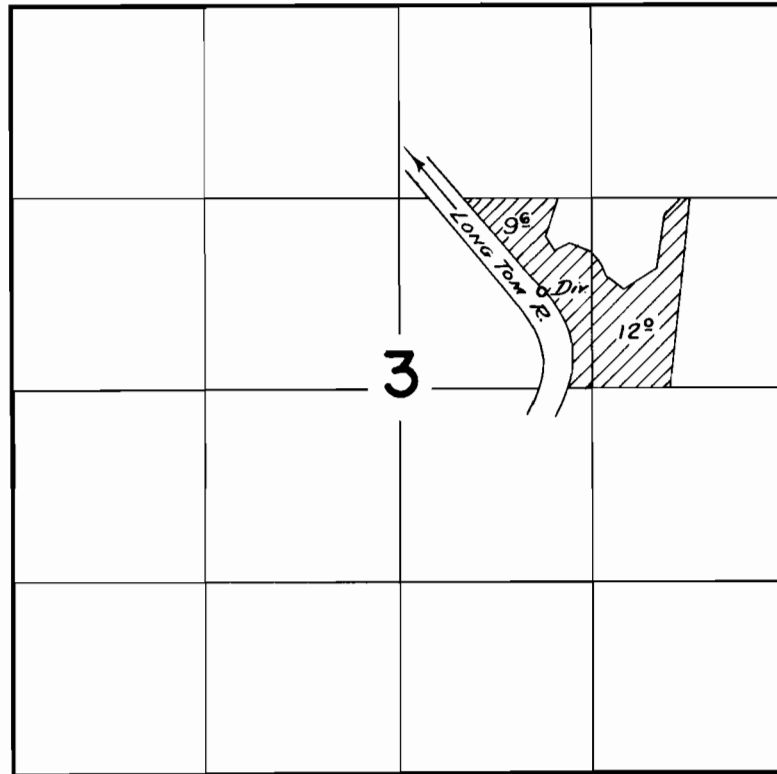

FINAL PROOF SURVEY
UNDER

Application No. 26373 Permit No. 20695
IN NAME OF

KIRKHAM BROS.

Surveyed July 27, 1961, by Carroll