


T.13S. R.7W.W.M.

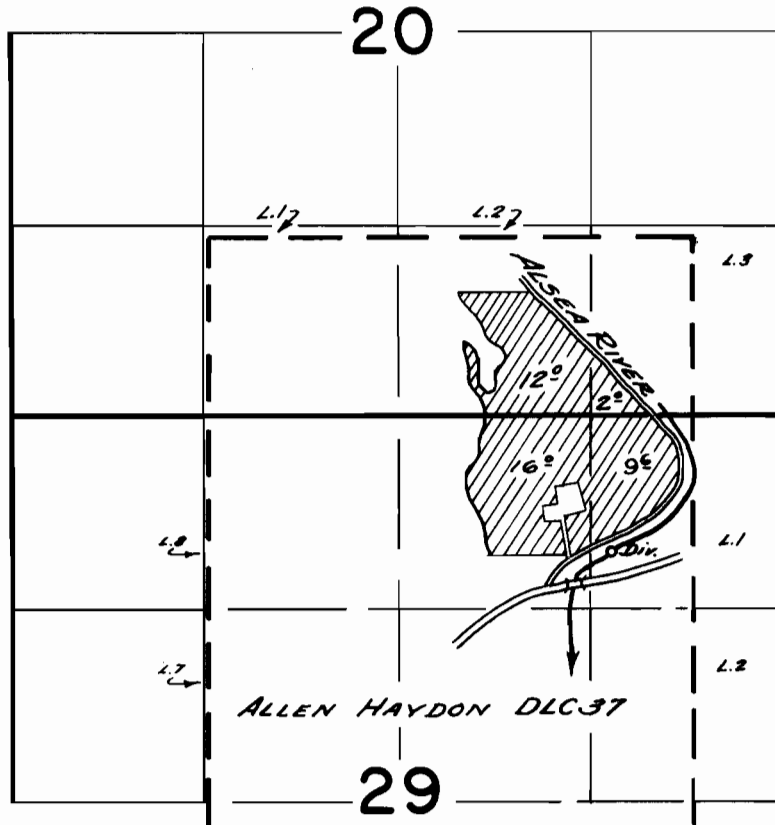

FINAL PROOF SURVEY
UNDER

Application No. 26716 Permit No. 21722
IN NAME OF

Howard Martin

Surveyed June 14 1961, by Co. Bartels