


# T.2S.R.4E.W.M.

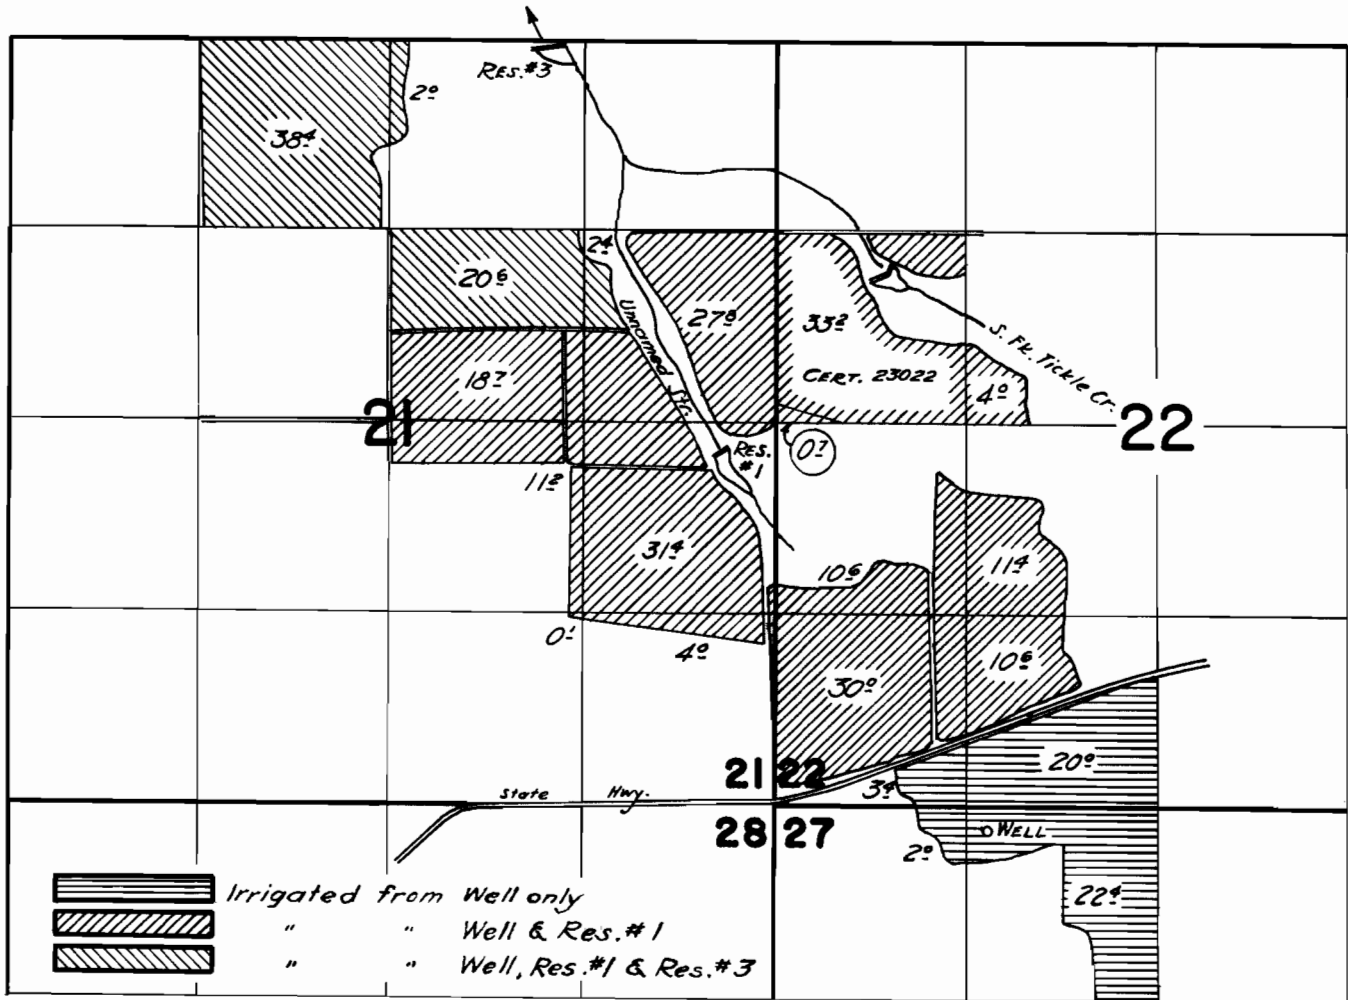

## FINAL PROOF SURVEY

UNDER

R-27865

27724

R-28782

28783

R-1441

21838

R-1572

22657

Application No. G-1497 Permit No. G-1393

IN NAME OF

**SANDY FARMS**

Surveyed Apr. 28, 1961, by

*R. Jackson*