


Copy

map from
file R-28218

T.4S.R.2E.W.M.

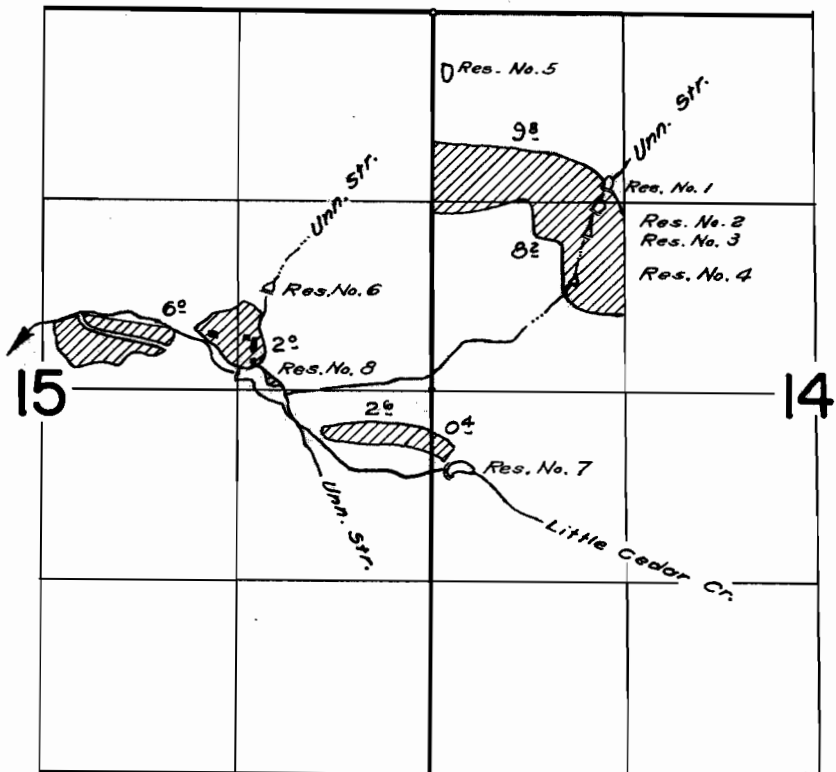

FINAL PROOF SURVEY
UNDER

R-28218 R-1520
Application No. 28219 Permit No. 22441

IN NAME OF
TOM & ALMA PEARL BURNS
HARRY E. & MILDRED ERTZ

Surveyed May 15, 1961, by L. Jackson