


T.2S.R.3E.W.M.

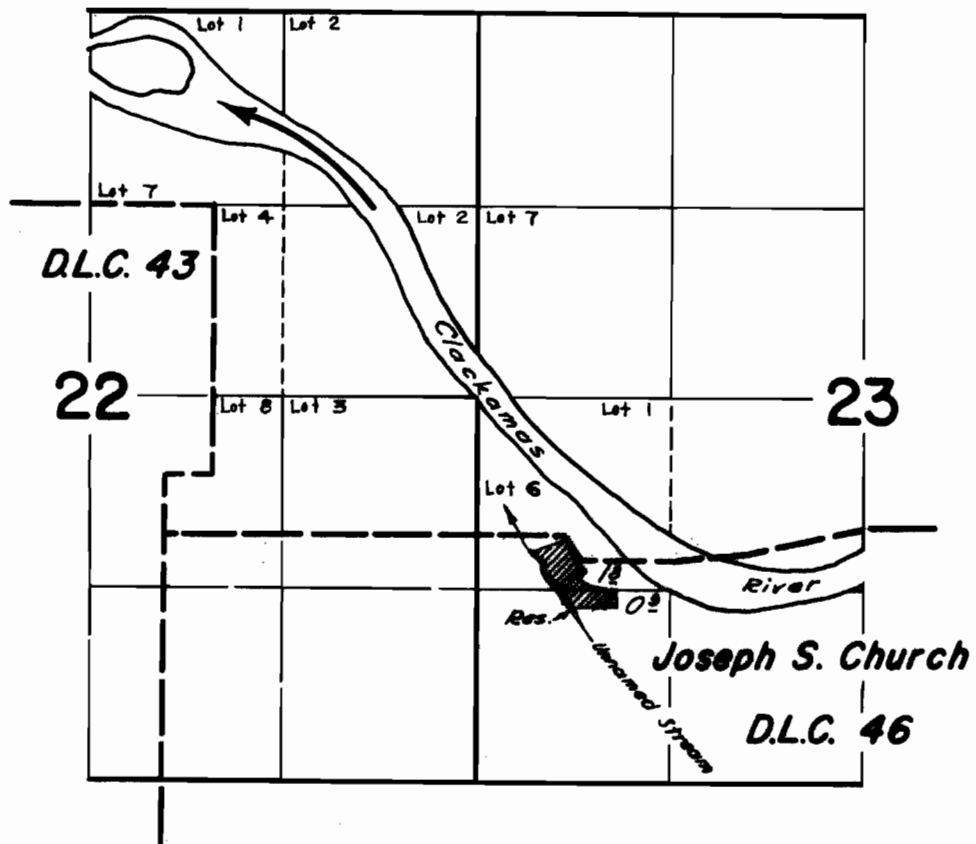

**FINAL PROOF SURVEY**  
UNDER

R-30628                      R-1885  
Application No. 30629 Permit No. 24306  
IN NAME OF

WILLARD C. BRISTLIN

Surveyed April 17, 1901, by [Signature]