


T.6S. R.1E. W.M.

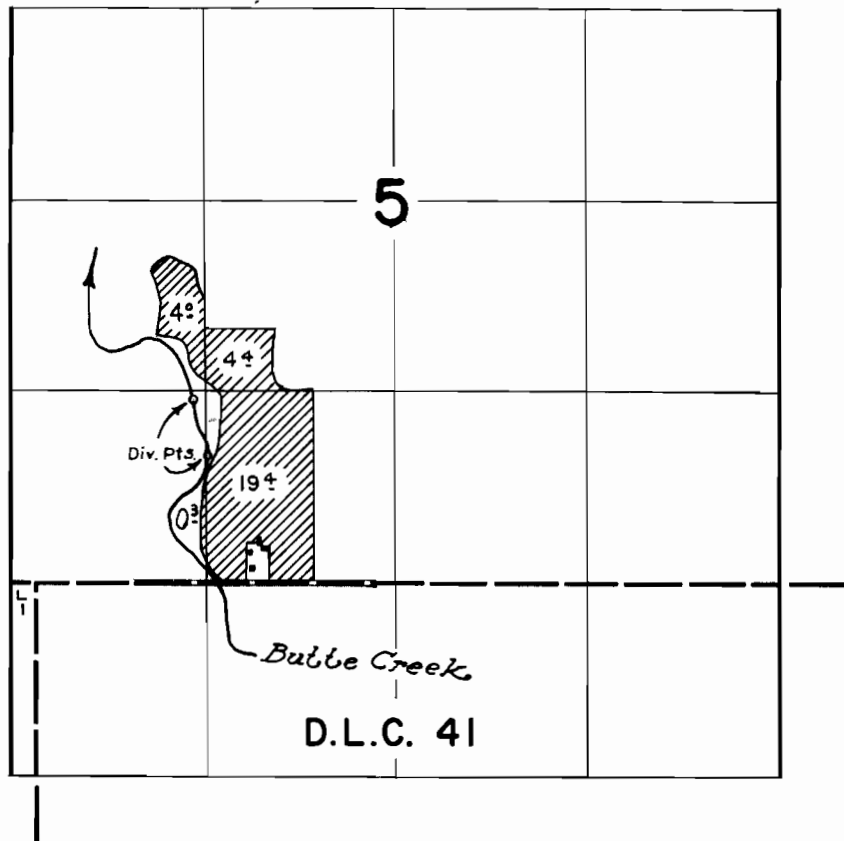

FINAL PROOF SURVEY UNDER

Application No. 31034... Permit No. 24396...
IN NAME OF

GERALD W. SPORALSKY

Surveyed June 1, 1961, by *R. Peterson*