


T. 41 S. R. 13 W. W.M.

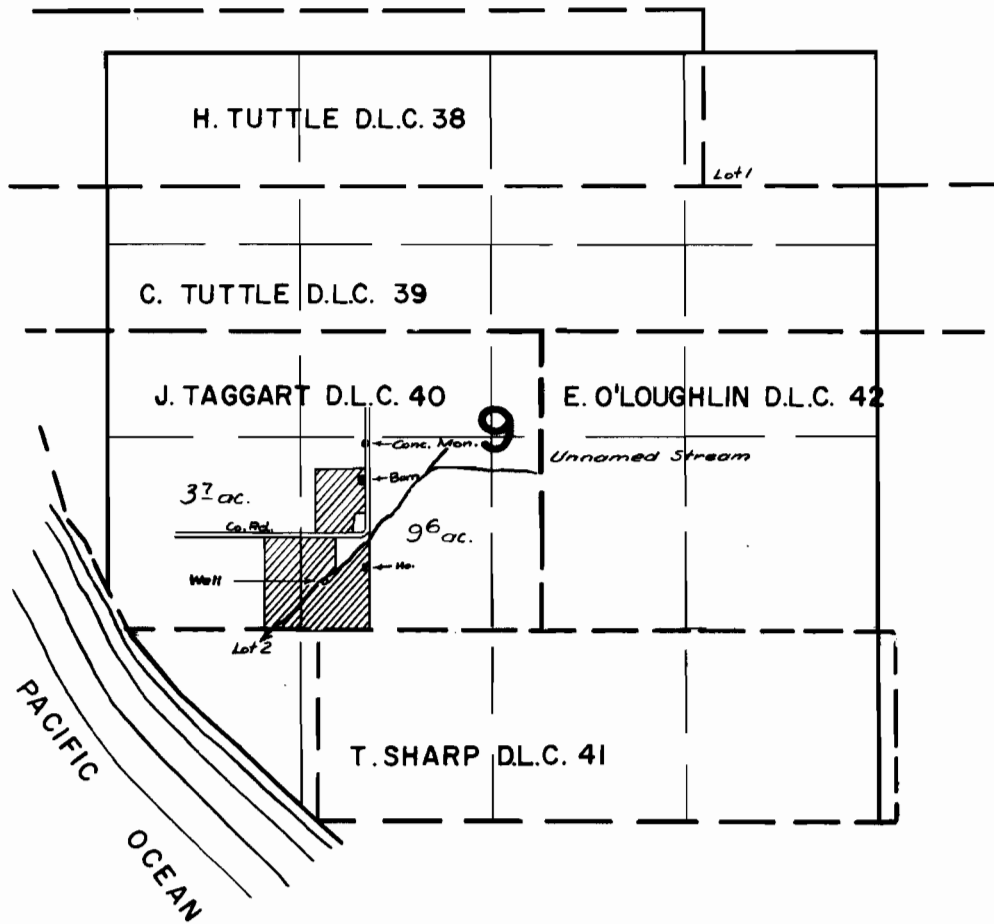

FINAL PROOF SURVEY UNDER

Application No. G-655 Permit No. G-568
IN NAME OF

HARVE J. STRAHM

Surveyed 3 AUG. 1961, by m. B. B.