


T. 33S. R. 10W. W.M.

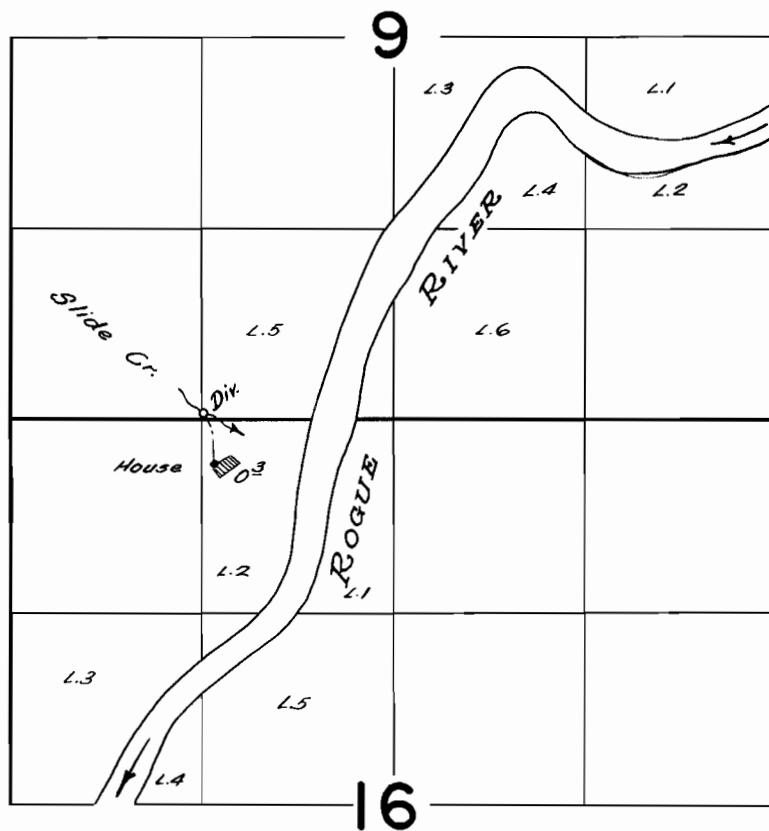

FINAL PROOF SURVEY
UNDER

Application No. 18771 Permit No. 14419
IN NAME OF

HARRY T. ROLFE

Surveyed Aug. 22, 1961, by C. B. Burt