


T.34S.R.IIW.W.M.

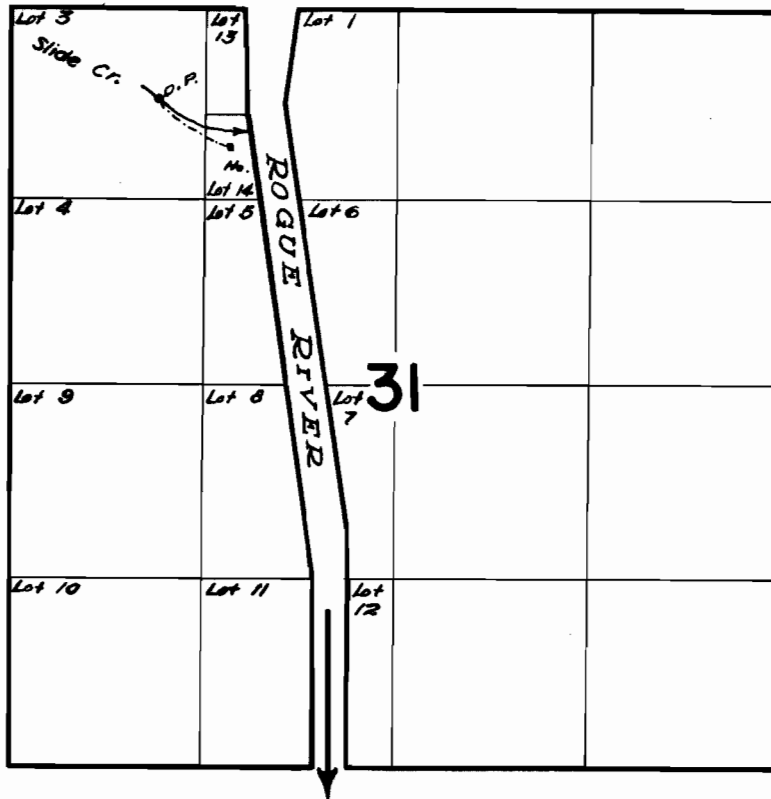

FINAL PROOF SURVEY UNDER

Application No. ~~21128~~..... Permit No. 16556.....
IN NAME OF

.....THEO. L. CLINTON.....

Surveyed August 29 1961., by C.O. Bartels.