


# T.35 S.R.11W.W.M.

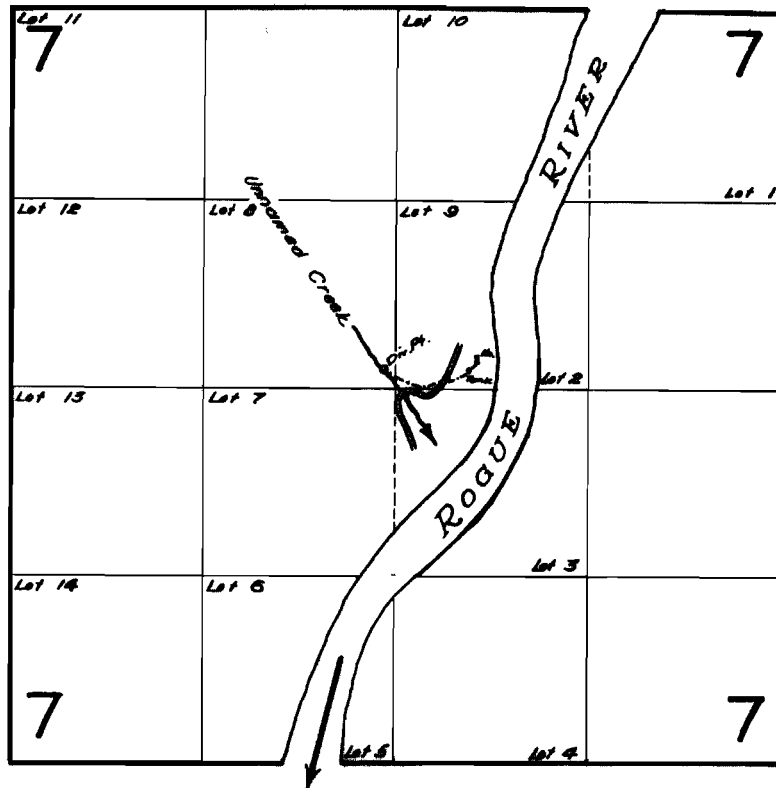

## FINAL PROOF SURVEY UNDER

Application No. **24393**..... Permit No. **19159**.....  
IN NAME OF

**G. F. HAMBRIGHT**

Surveyed *August 27 1961*., by *C.O. Bartels*..