


T.36S. R.14W.W.M.

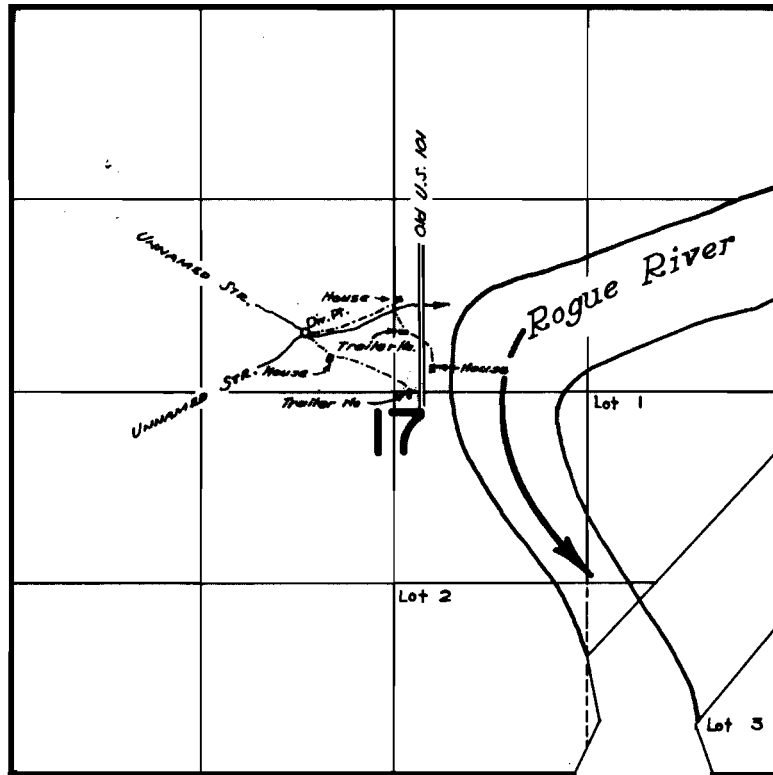

**FINAL PROOF SURVEY**  
UNDER

Application No. **30382**... Permit No. **23976**....  
IN NAME OF

**CHARLES WILLIAM CRONENWETT**

Surveyed *August 5, 1961*, by *[Signature]*