


T.37S.R.14W.W.M.

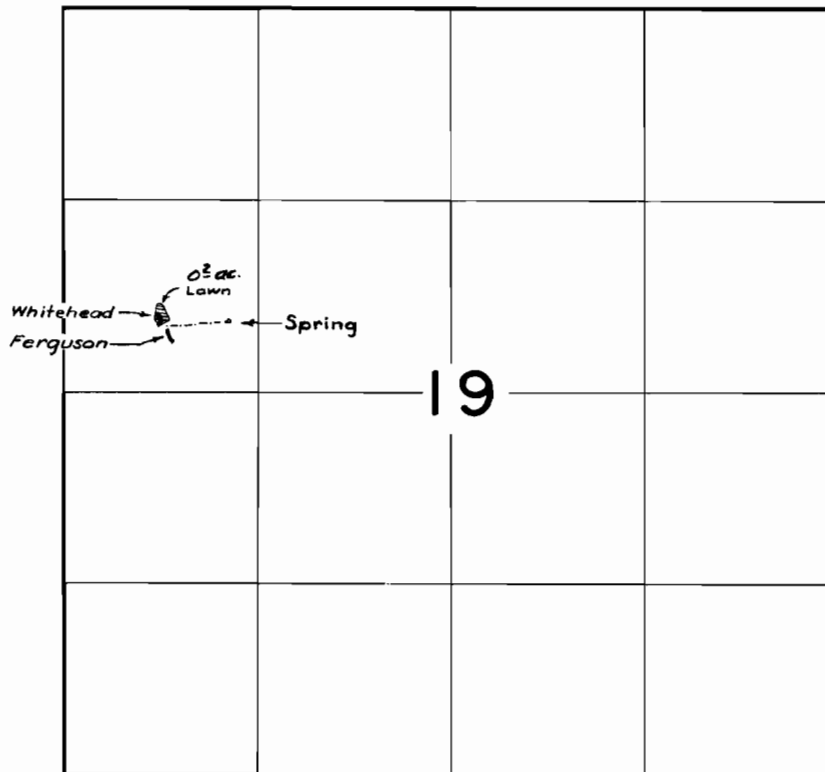


FINAL PROOF SURVEY
UNDER

Application No. 30541 29480 Permit No. 24047 23194 WHITEHEAD
IN NAME OF FERGUSON

Lee Eldon & Esther Ruth Whitehead

Surveyed 5 AUG 1961, by M. Bish

T.37S.R.14W.W.M.

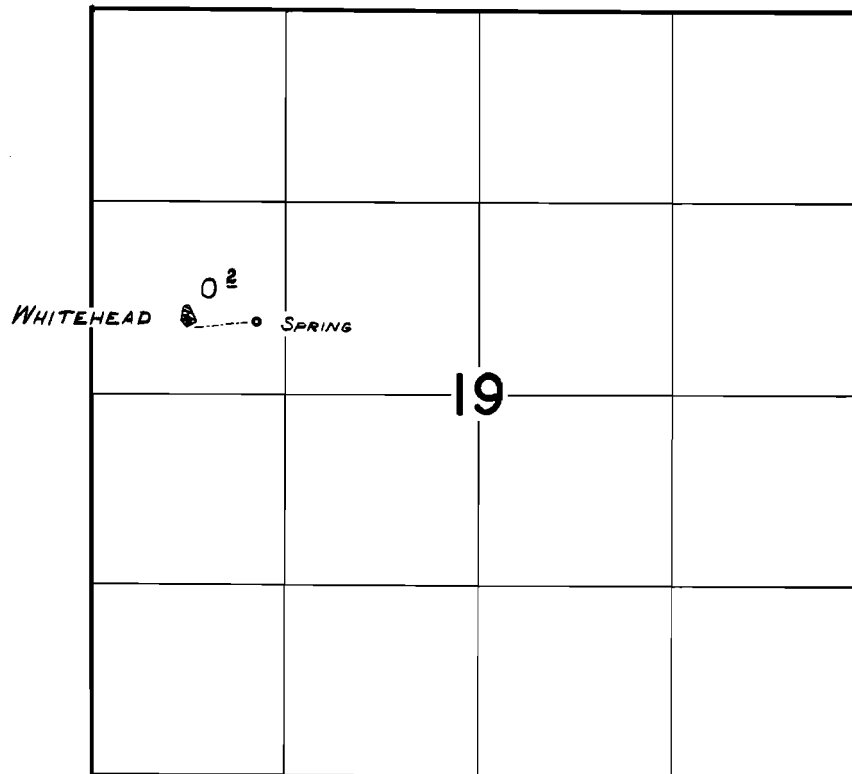

FINAL PROOF SURVEY
UNDER

Application No. **30541** Permit No. **24047**
IN NAME OF

LEE ELDON & ESTER RUTH WHITEHEAD

Surveyed **AUG. 5, 1961**, by **M. BISH**