


T.36S.R.14W.W.M.

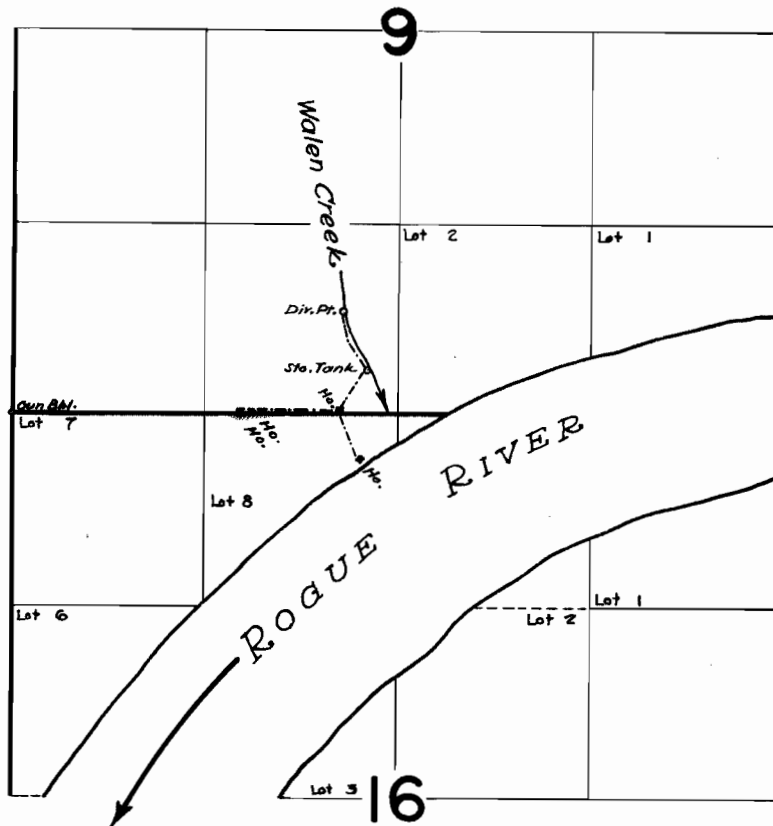

FINAL PROOF SURVEY
UNDER

Application No. 30837 Permit No. 24320
IN NAME OF

HAROLD V. & IRENE A. WALEN

Surveyed August 1, 1961, by R. J. Jackson